


3913

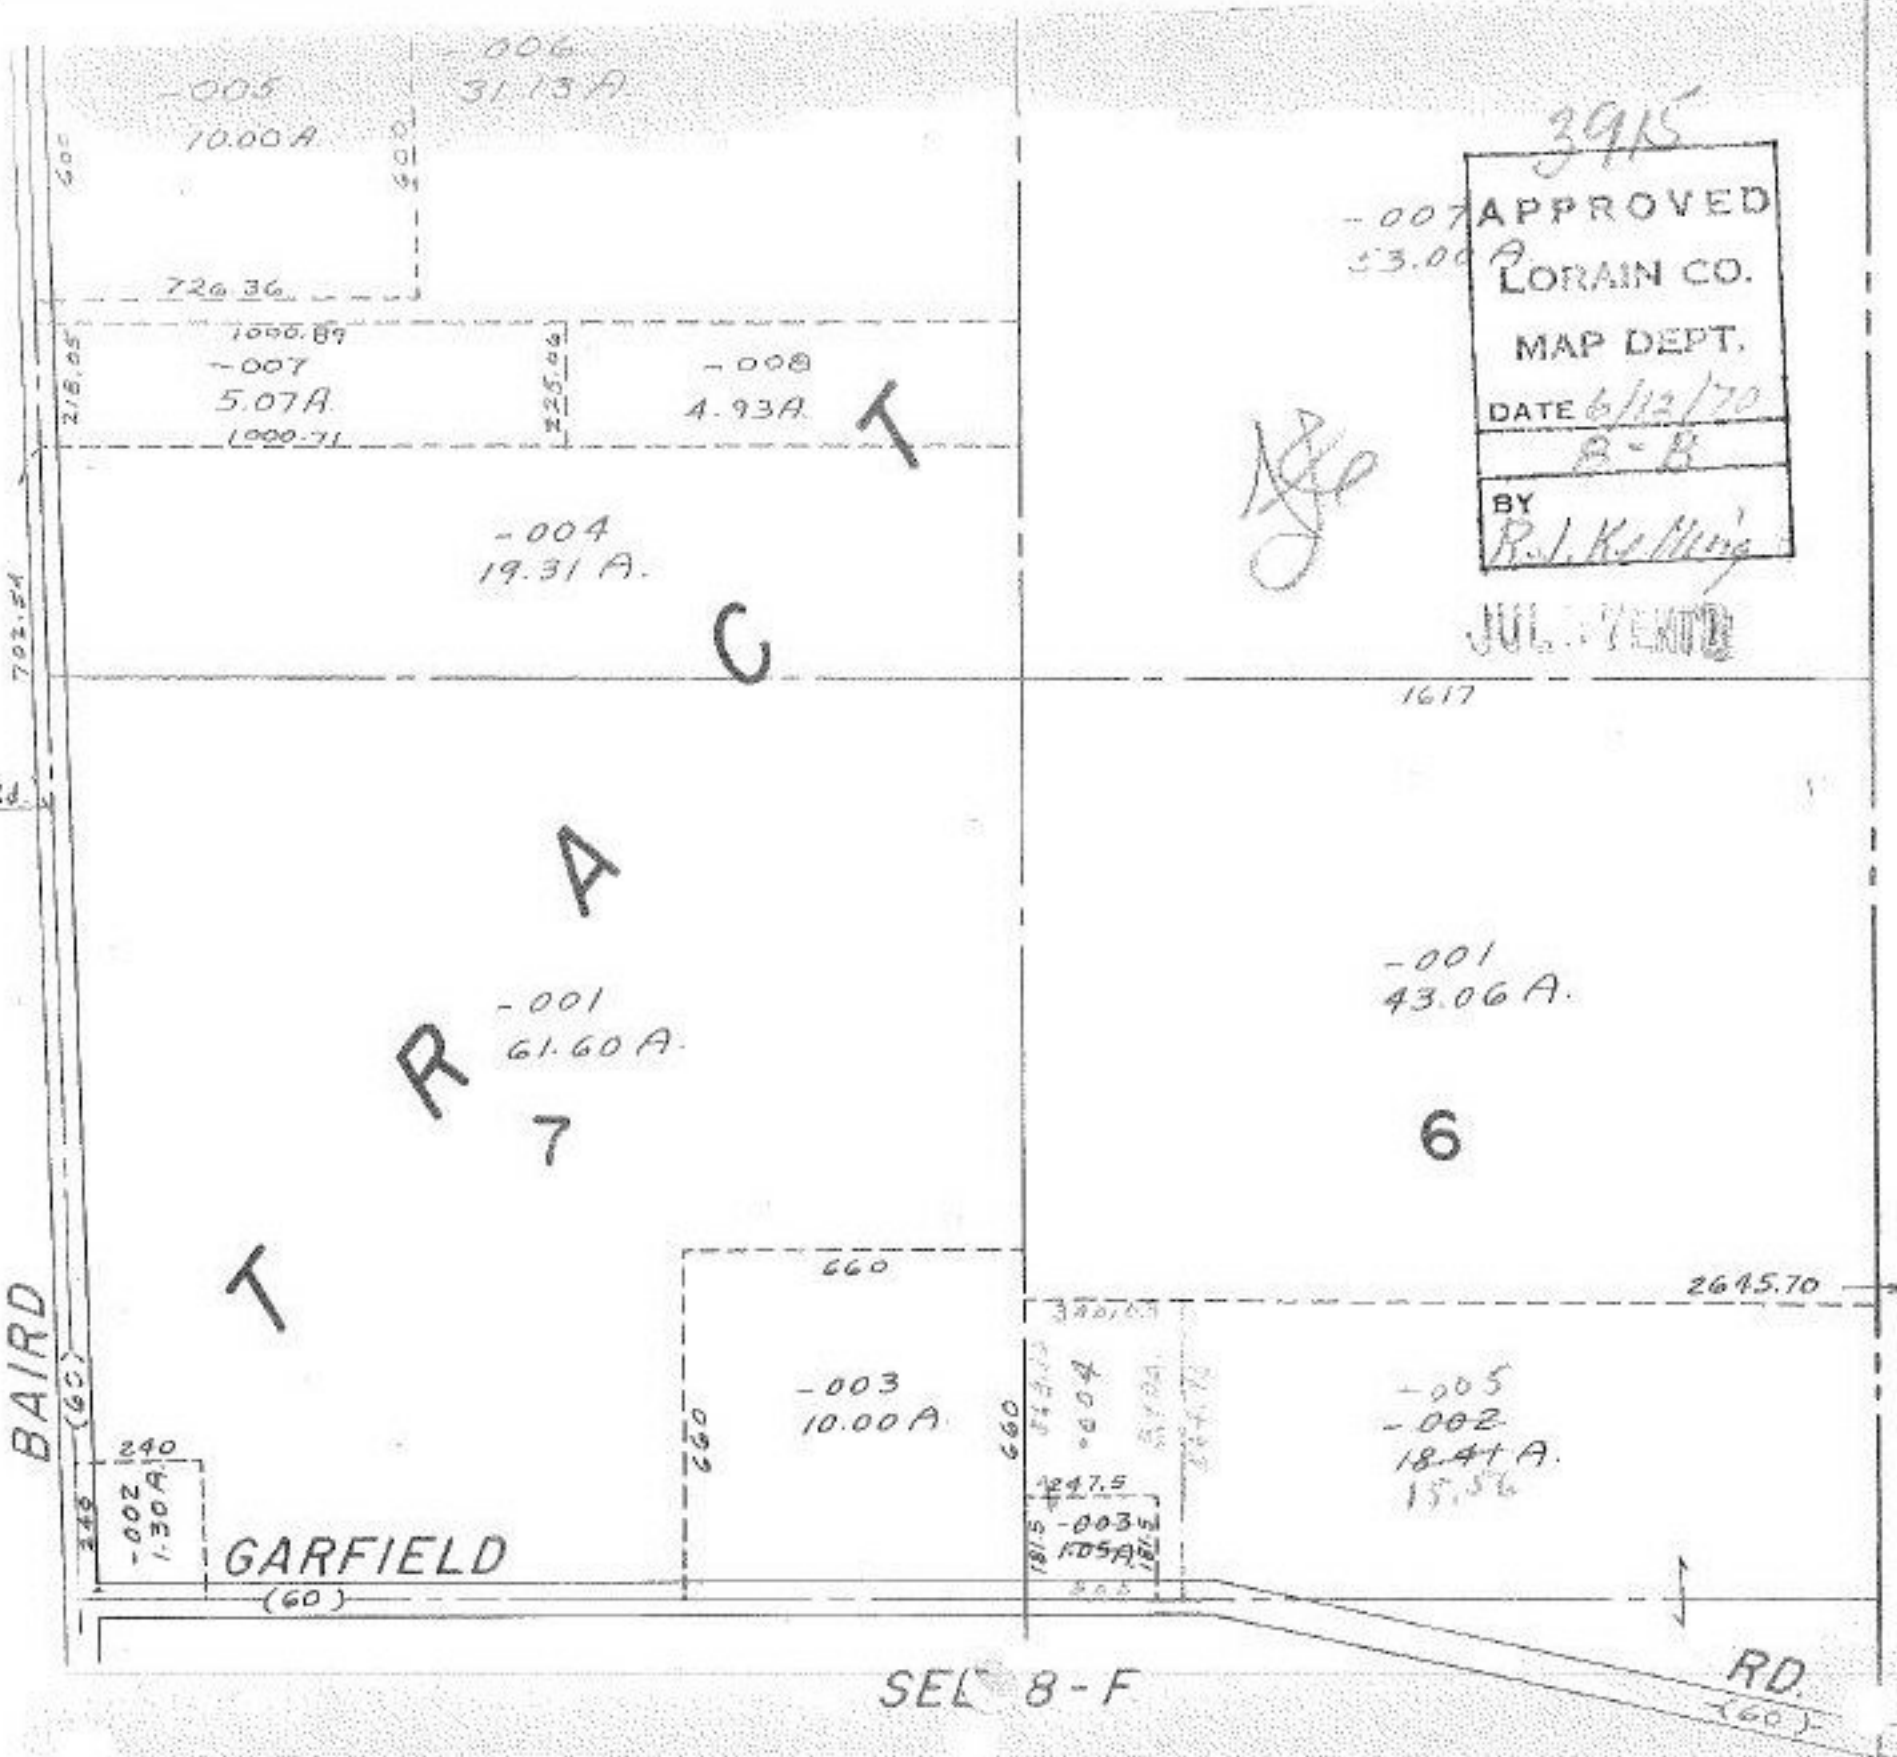

3915

-007 APPROVED  
53.00 A  
LORAIN CO.  
MAP DEPT.  
DATE 6/12/70  
B-B  
BY  
R. L. Keating

JUL 1 1970

*[Handwritten signature]*

N  
A  
D