


DL 753-14 4/30-4/31
This deed incomplete

Done on

Map K-13
LW 70

Master Reg &
number Maps corrected
6-22-70
LW Hall

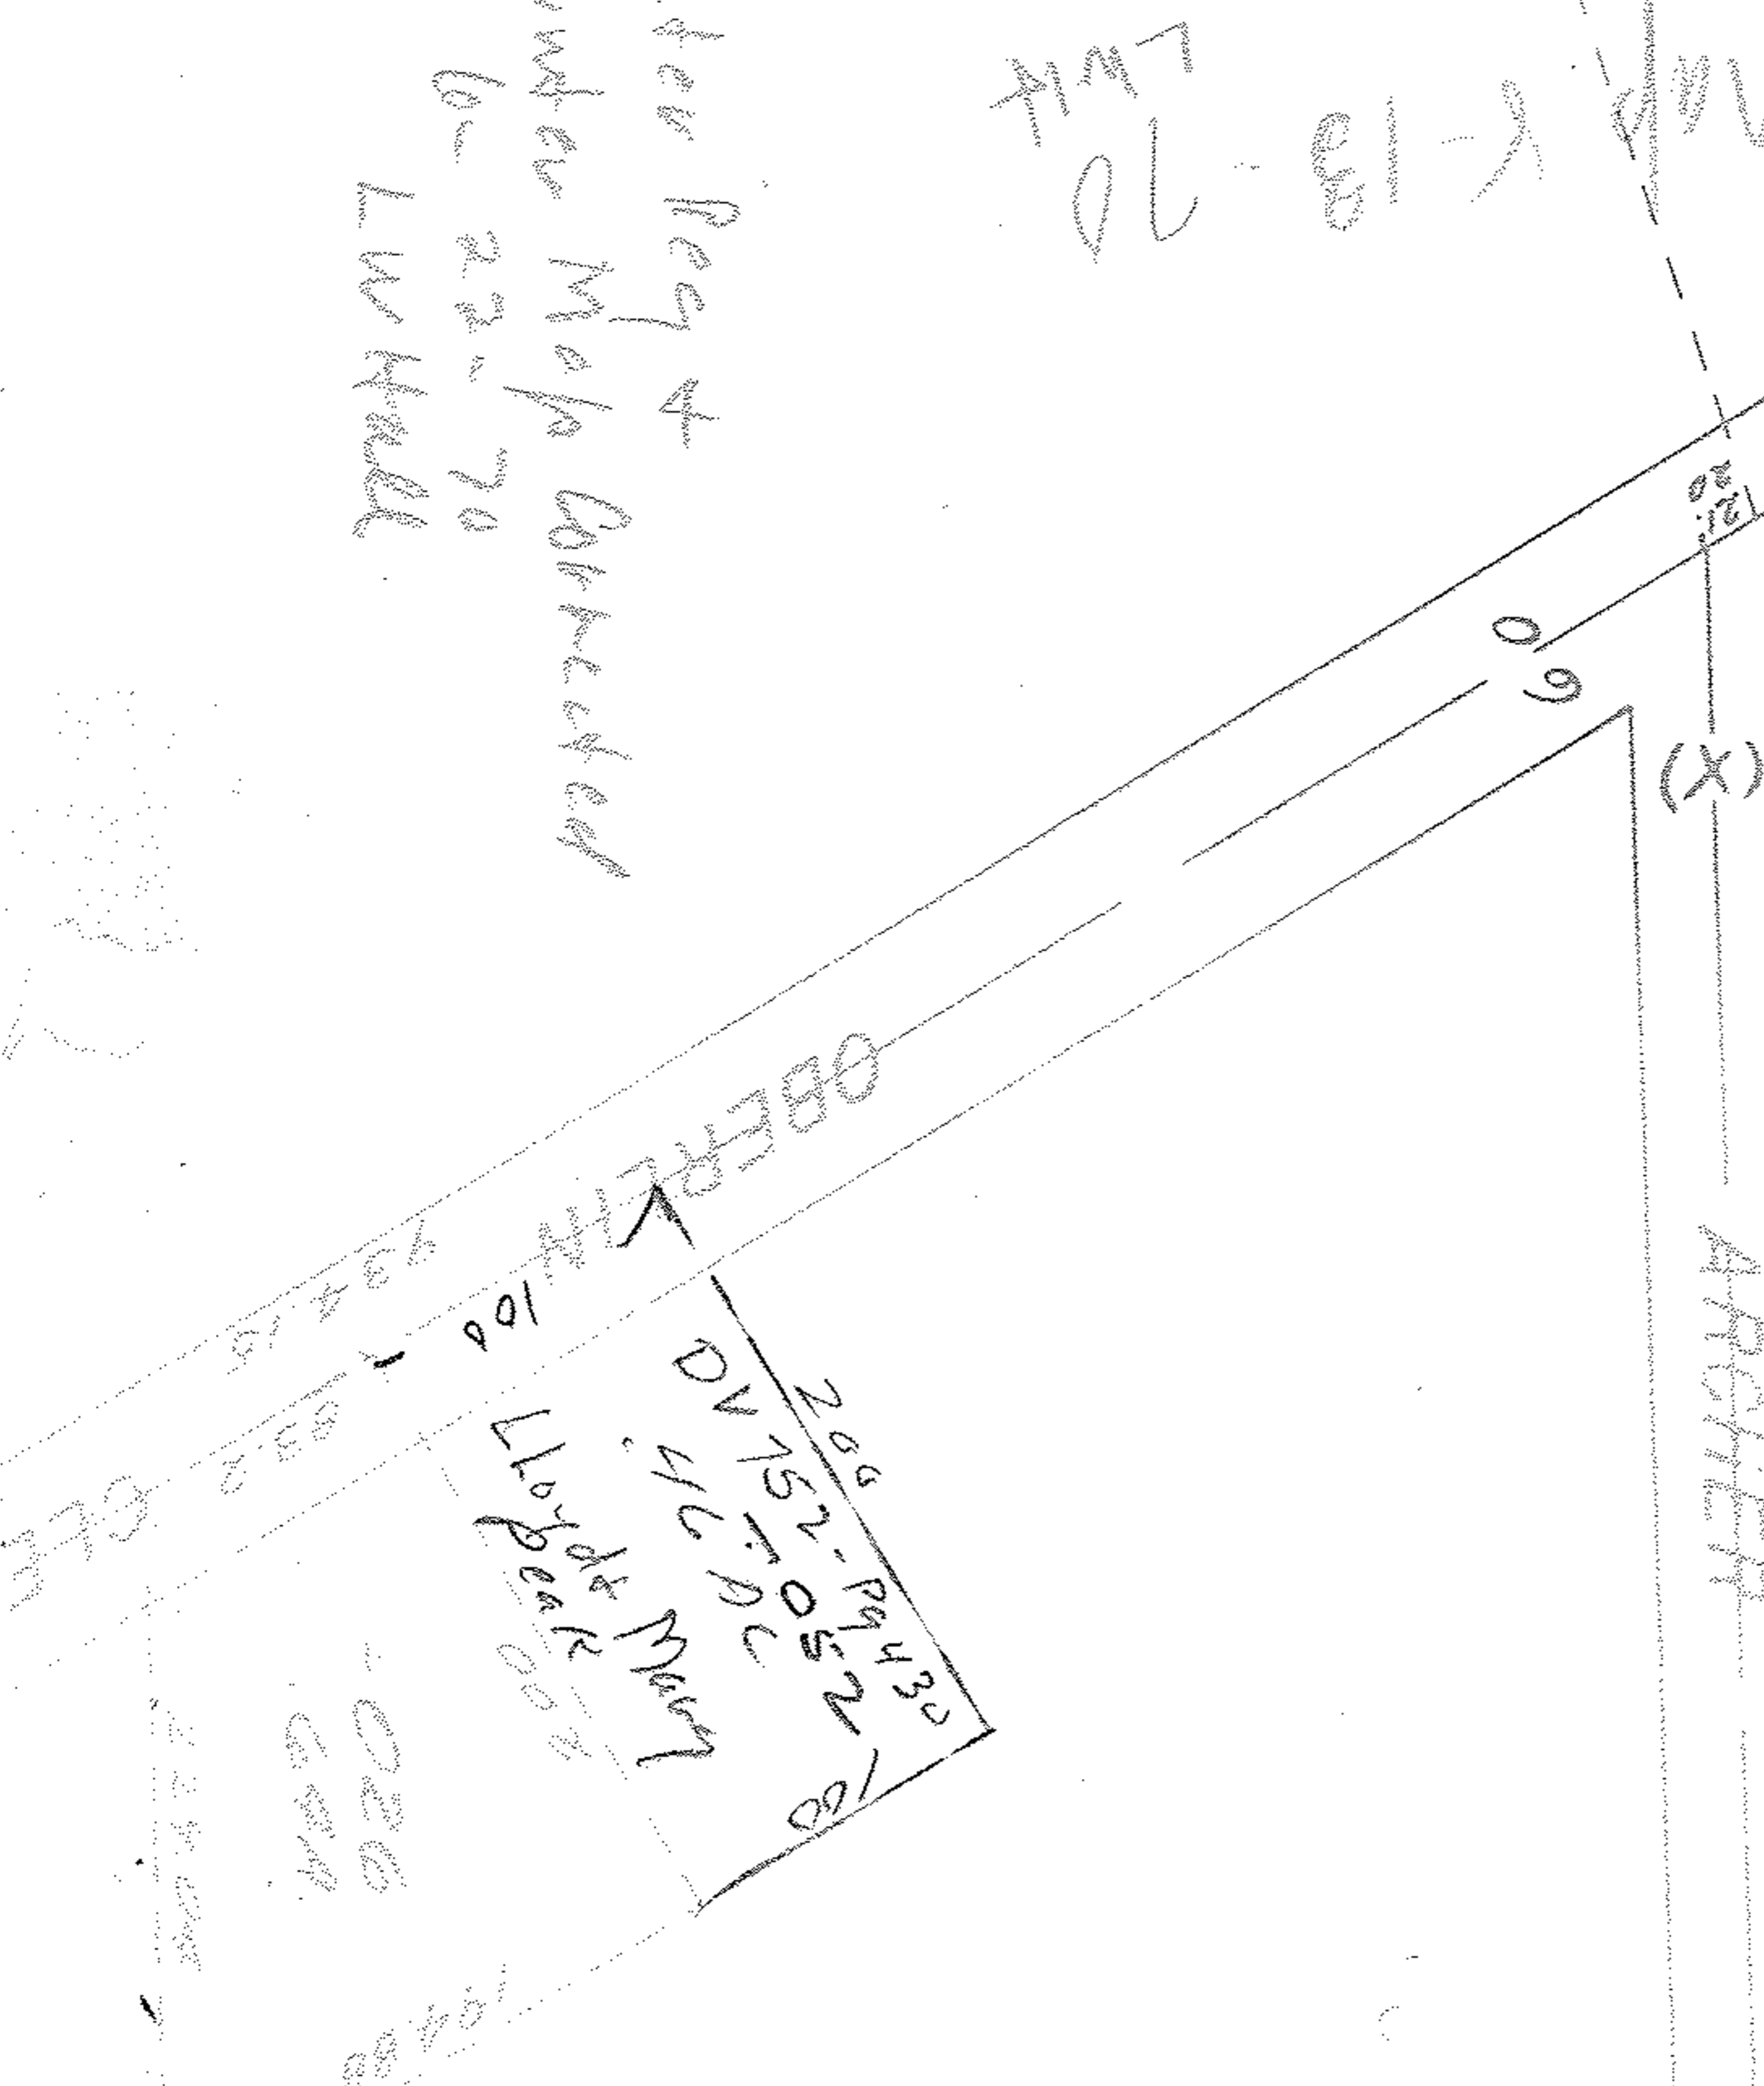

#3990
 APPROVED
 LORAIN C.
 MAP D...
 DATE 10-28-70
 BY L.W. Hall



SEE 11-00-070-A

3990

-025
20.07A

Lloyd Perkins
11/6/70

-025
~~20.07A~~
~~20.07A~~
~~20.07A~~
 20.07

11-00-070 B

3990

RD