



APPROVED
 EORIN CO.
 MAP DEPT.
 DATE 6/25/70
 1-70-029-B
 P.L. Kealey

4002

2-1/2 map
 4002

7-17-96
 GS

1
 D
 P
 0
 0
 0

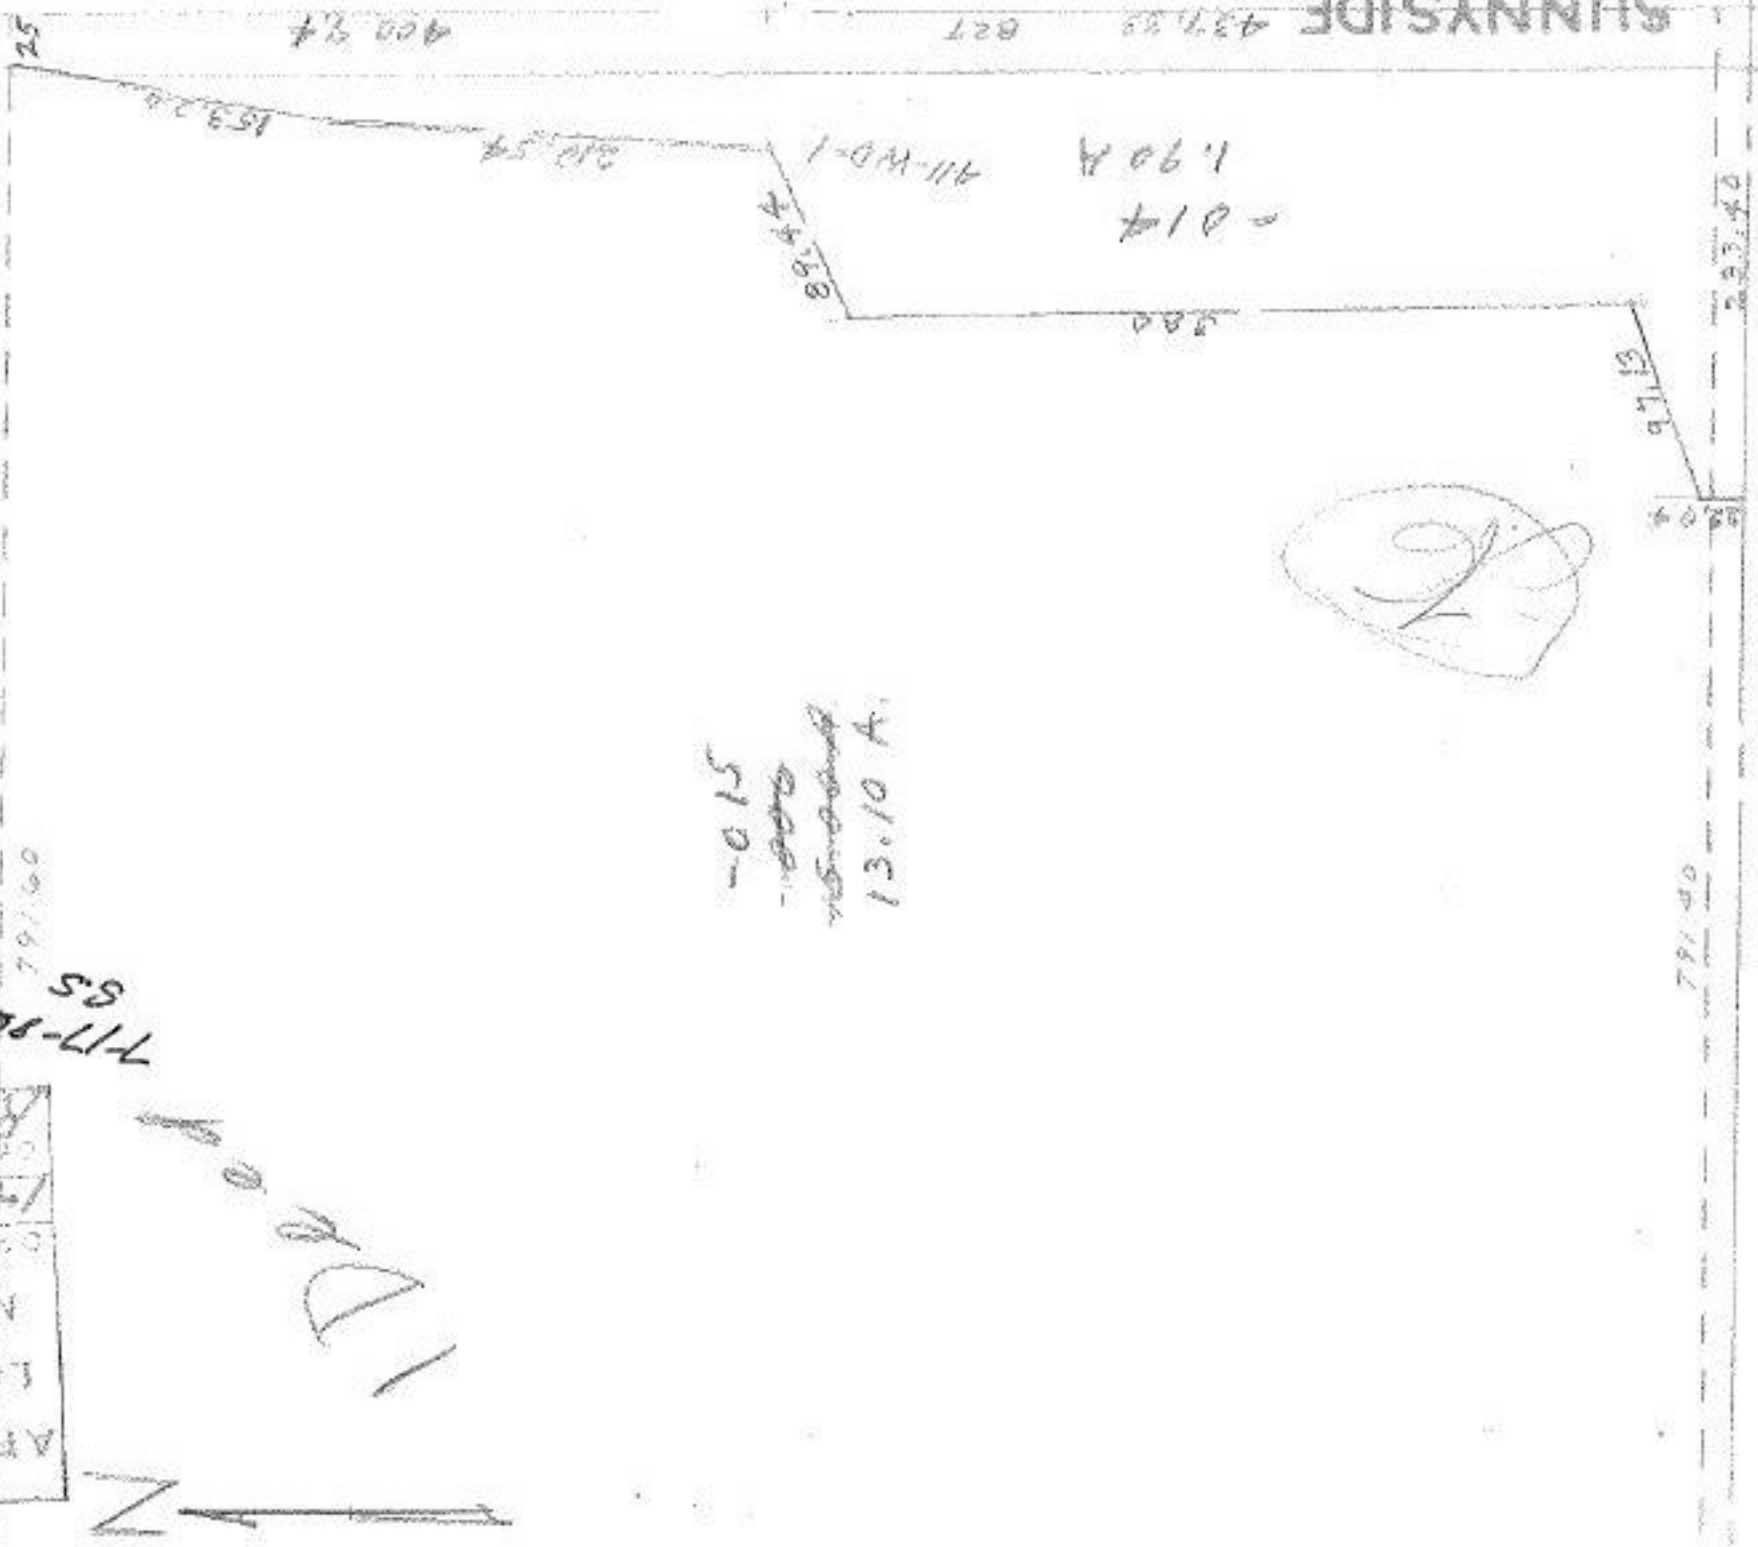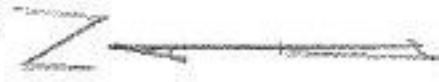

1-00-029-B