


a-b x 8000
 a-115 x 1.077
 a = 124.11

124.11
 117.00
 L 241.110
 k e
 PG 4-00-019-D

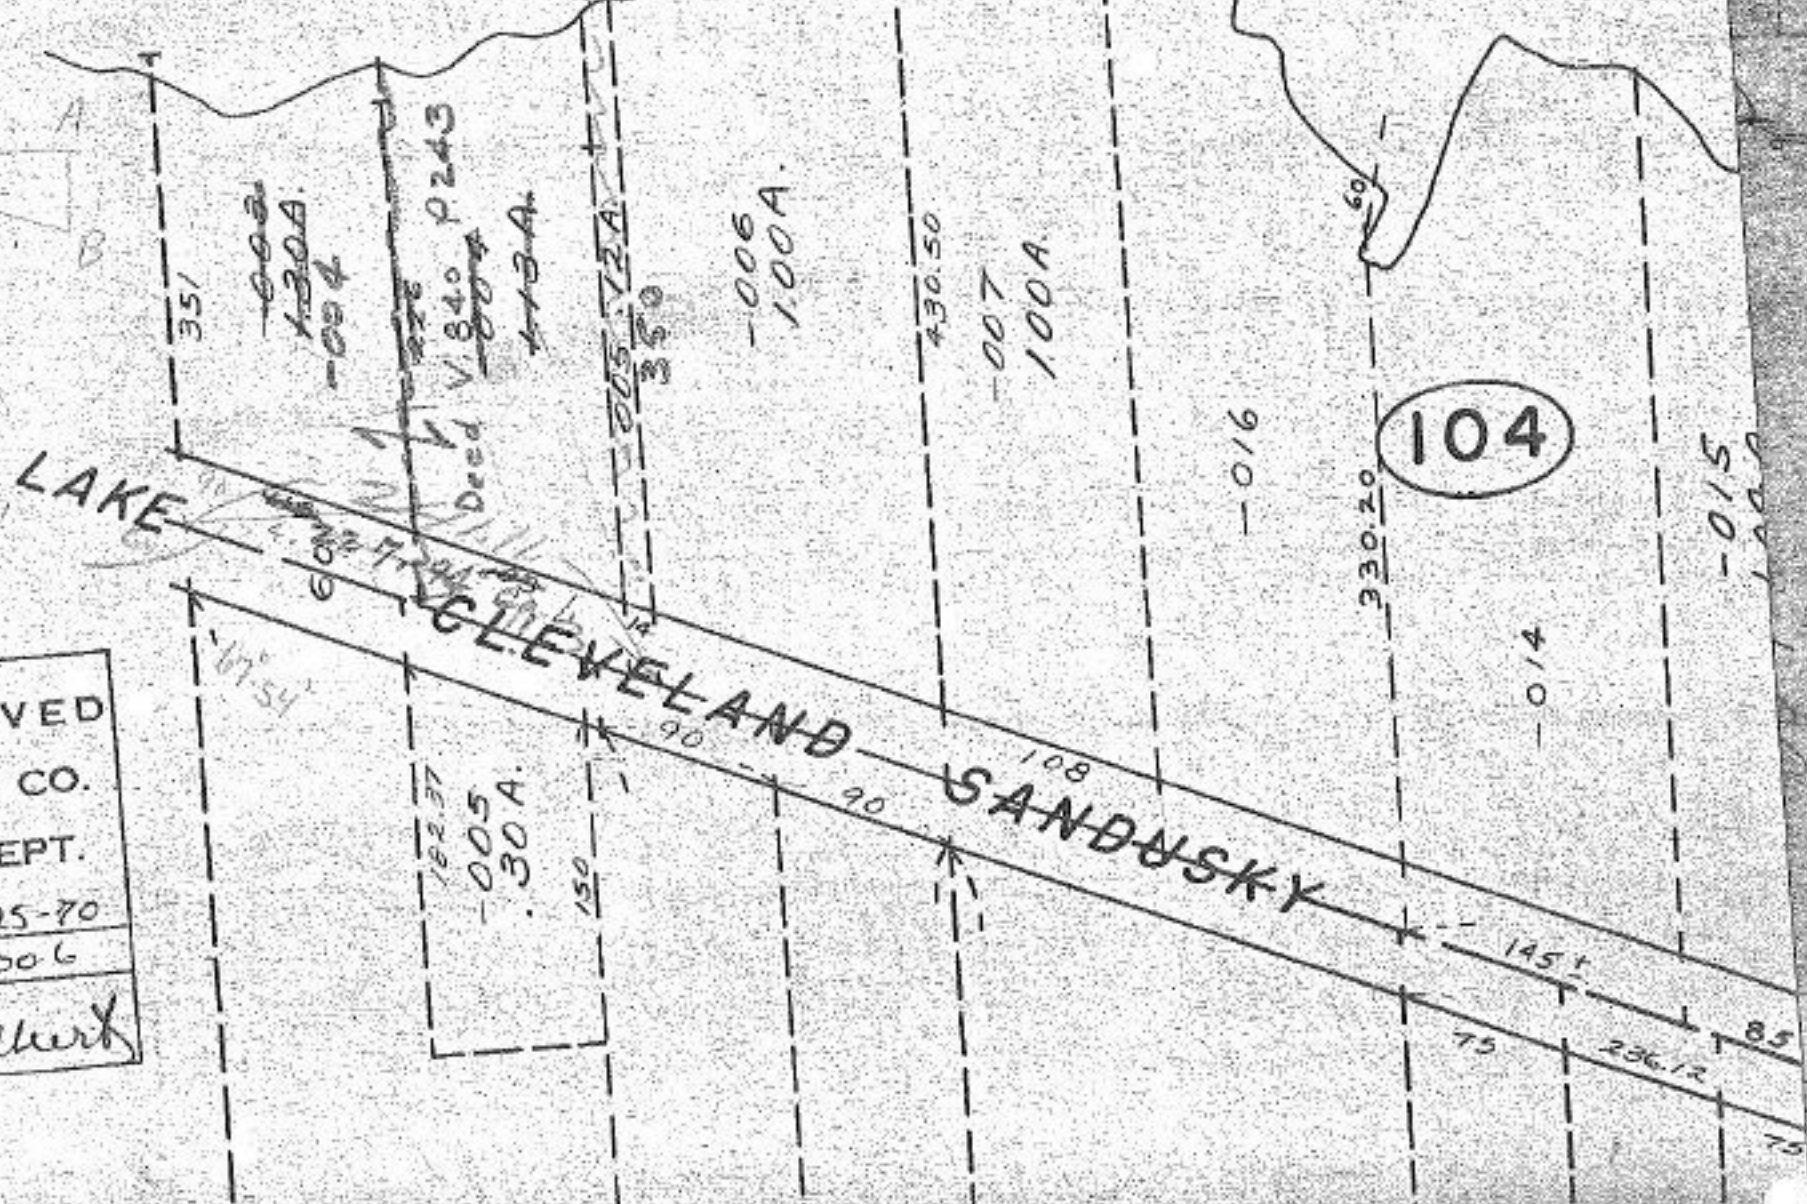

APPROVED
 LORAIN CO.
 MAP DEPT.
 DATE 6-25-70
 # 4006
 BY *H. K. ...*

41970
 11-10
 ...