


#4059

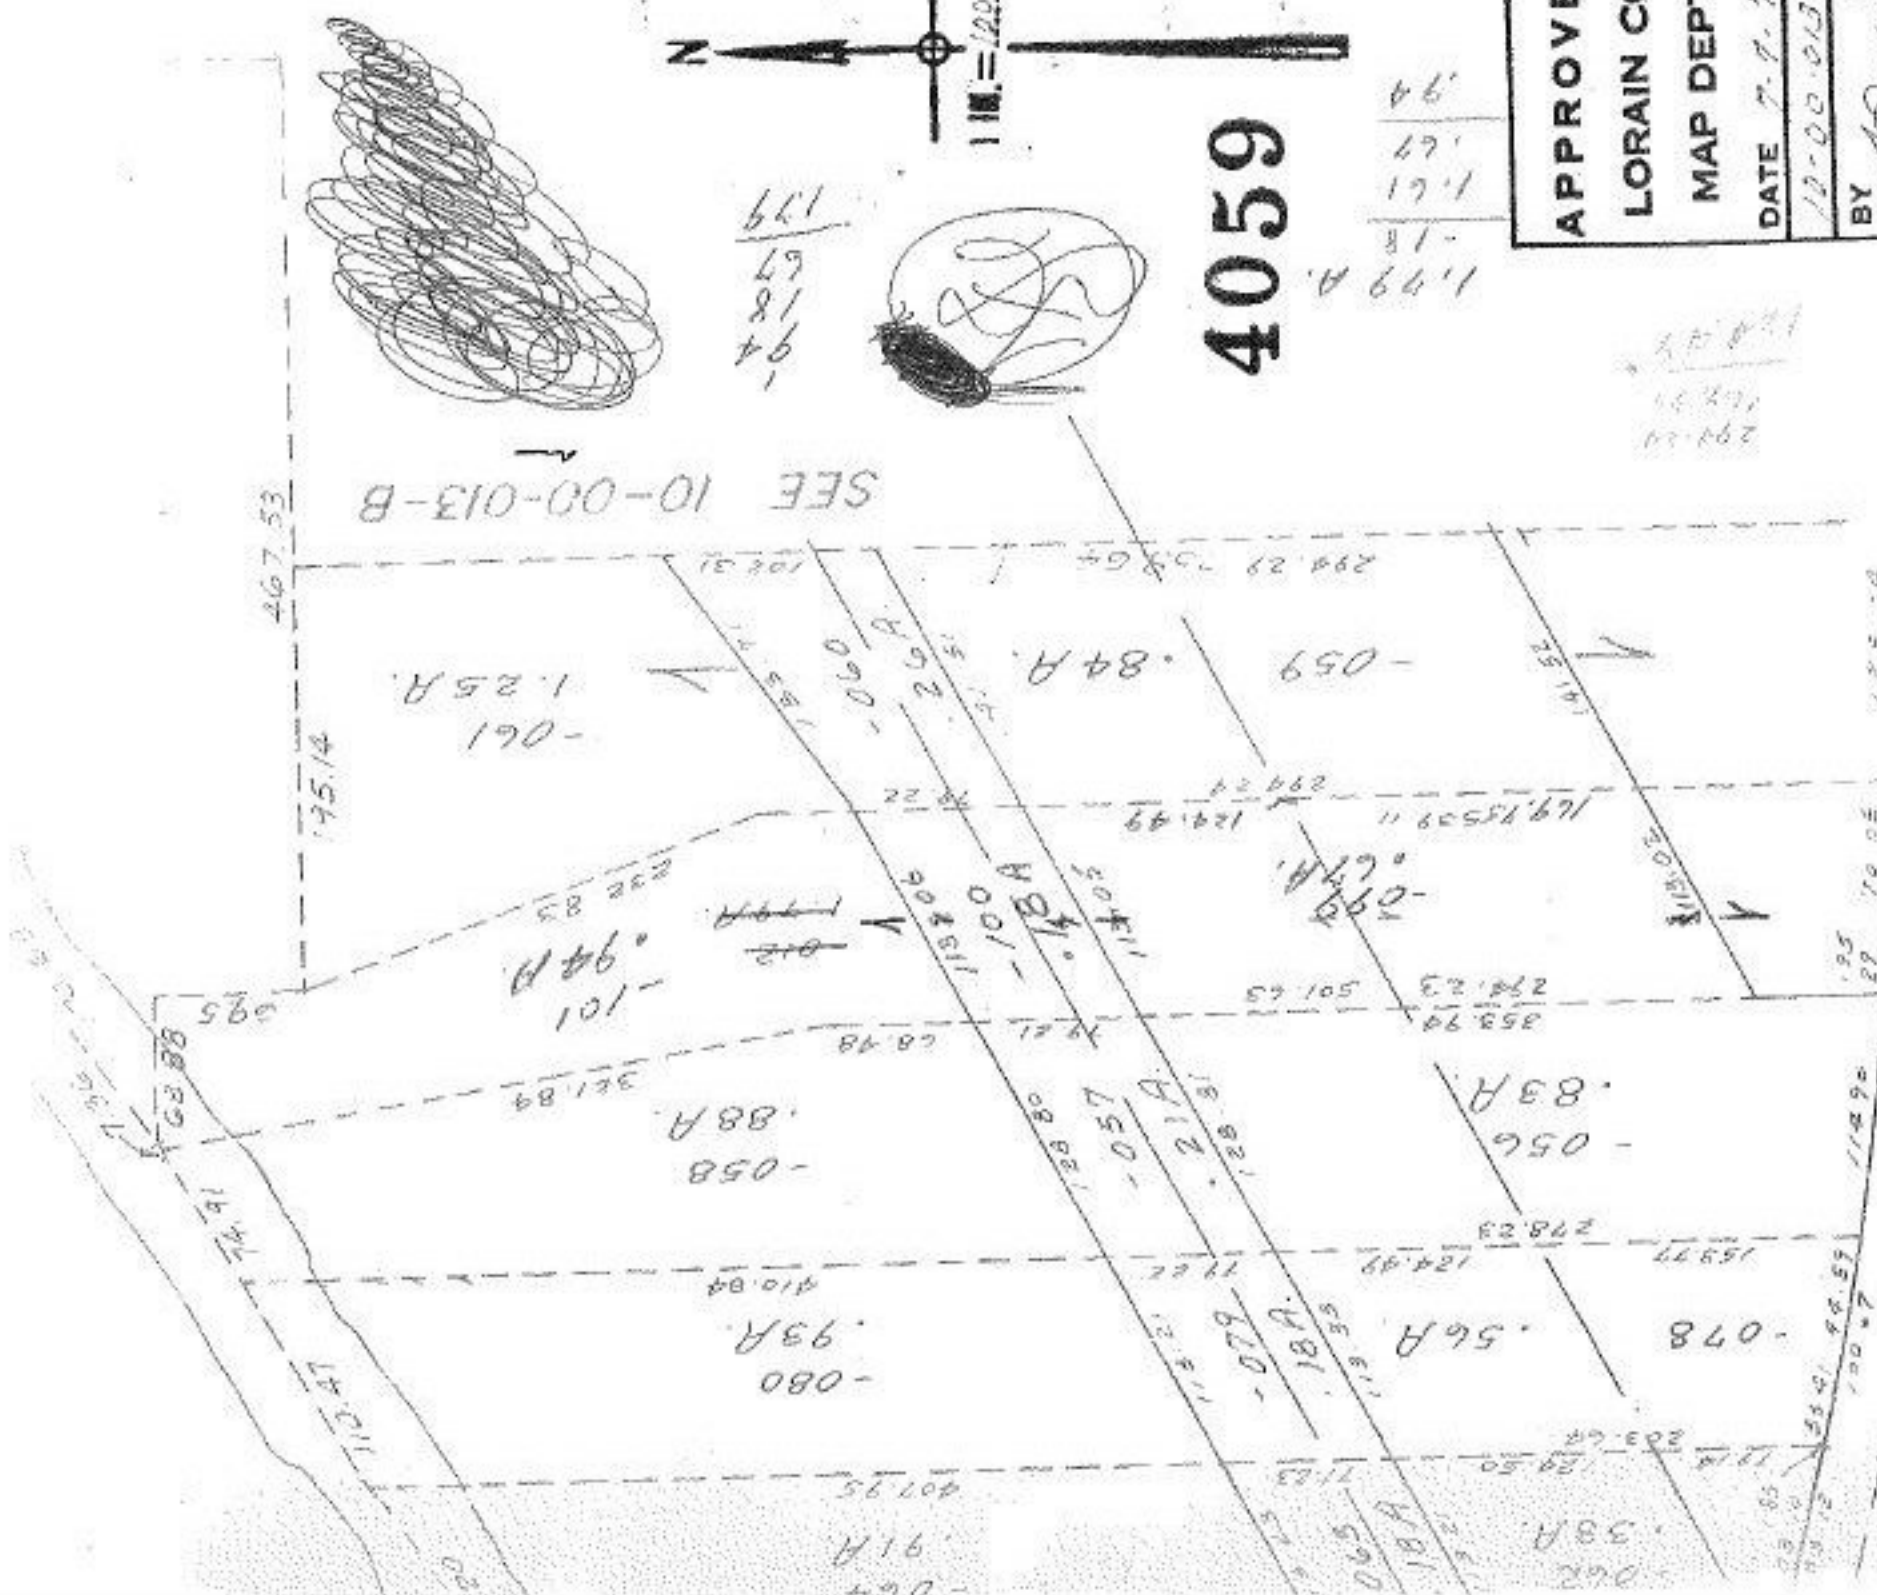

4059

1.99 A.  
-18  
1.61  
1.67  
94

APPROVED  
LORAIN CO.  
MAP DEPT.  
DATE 7-7-76  
12-00-013-A  
BY *[Signature]*

S.S.  
7-23-76

Done on Maps 8-14-76/11/11  
10-00-013-A