

#4005

CT #17

-005  
49.57 A.

A

2177.34

765

973.3  
1025

-002  
15.92 A.

-001  
26.16 A.

T

-002  
16.67 A.

Hawley Rd

B

-003  
44.53 A.


1725

G

219 50  
-005 670 156 A.  
704  
16

217.80  
-006  
1.00 AC

~~004 007~~  
85.68 A.  
B41.6 A.C

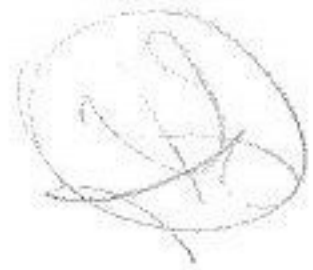

RD.

822.75  
-017  
1.50 A  
822.75

4005

APPROVED
LORAIN CO.
MAP DEPT.
DATE 7-7-70
BY ZIC
BY L. W. [Signature]

Bersley

1575  
1628.20

8-13-70

On Map LWA

ZIC