

SE 58

715.73

-012  
3.50 A

947.12

171.07

248.44  
290.45

-004  
1.00 A

231.27  
290.45


(150)

27.20  
A 1.68

Pt. ~~all~~

Pt. 59.45 A -013  
55.95

Change No. 4 Acre  
ON Pgs. 9-00-105-A

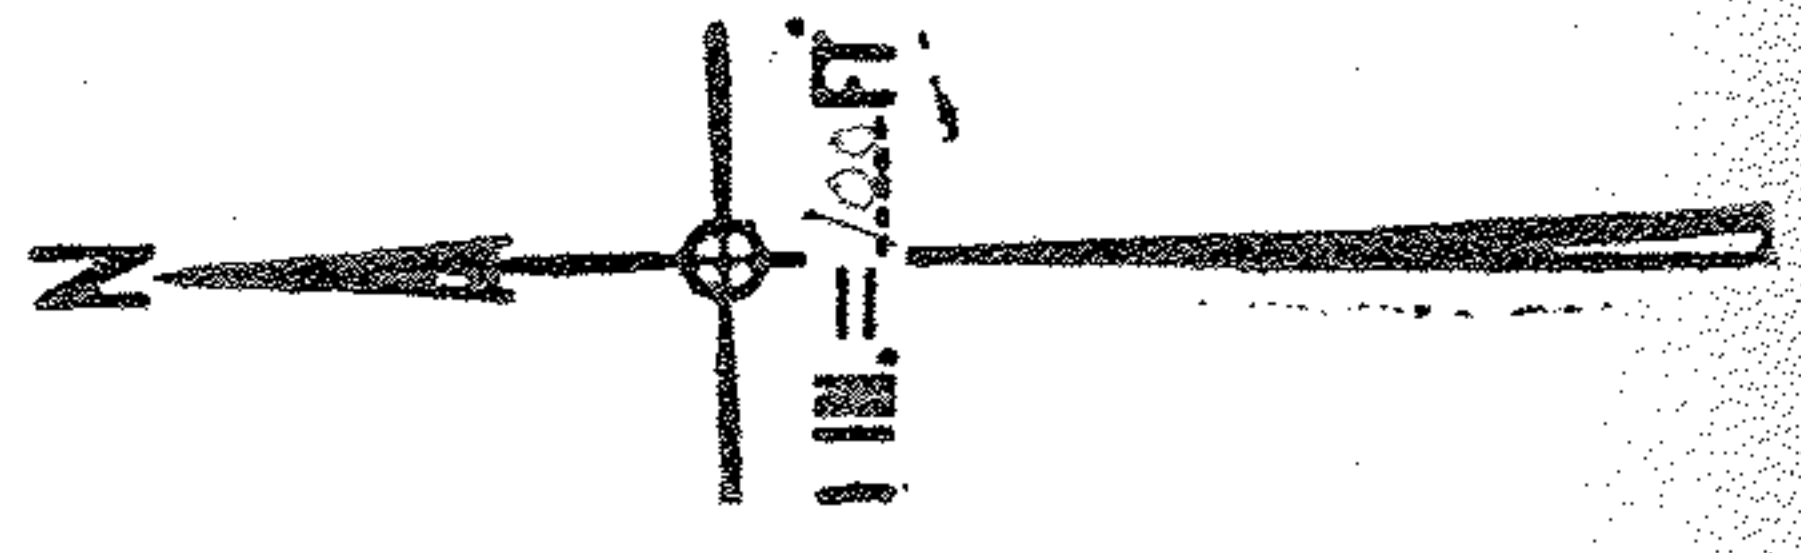

28-22-1-2  
8-1-2

4076

APPROVED
LORAIN CO.
MAP DEPT.
DATE 7-9-70
9-00-105-A+B
BY <i>[Signature]</i>

218.75

-009  
.41 A

234.96  
218.75

82

ASHLELAND

JUL 27 1970