

40 94
40 93


13.29 A. ~~13.25 A.~~

-017 -036
15.31 AC
14.94 A

#4094

APPROVED
LORAIN CO.
MAP DEPT.
DATE 7-16-70
3-00-001A
BY L.W. Hall

Y.M.S.

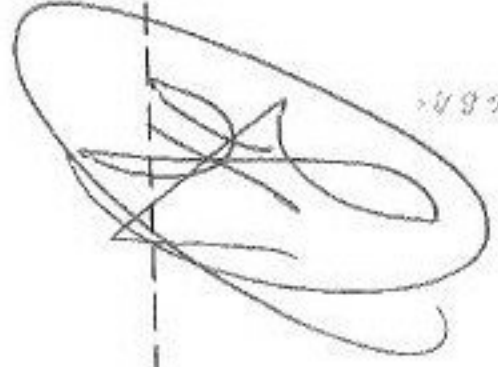

2400 143500 = 0.25 A

147 W D 143500
147-5
16.035:43520 = 0.268 A

1152 + 34.08
1154 + 10
1 29 08

147 W D

-037
147 W D

445.83
-035
147 W D

ABBE
445.83
-025
445.83
AIR

3-00-001A

Done on Maps 8-14-70 L.W.H.