



3

RD 4113

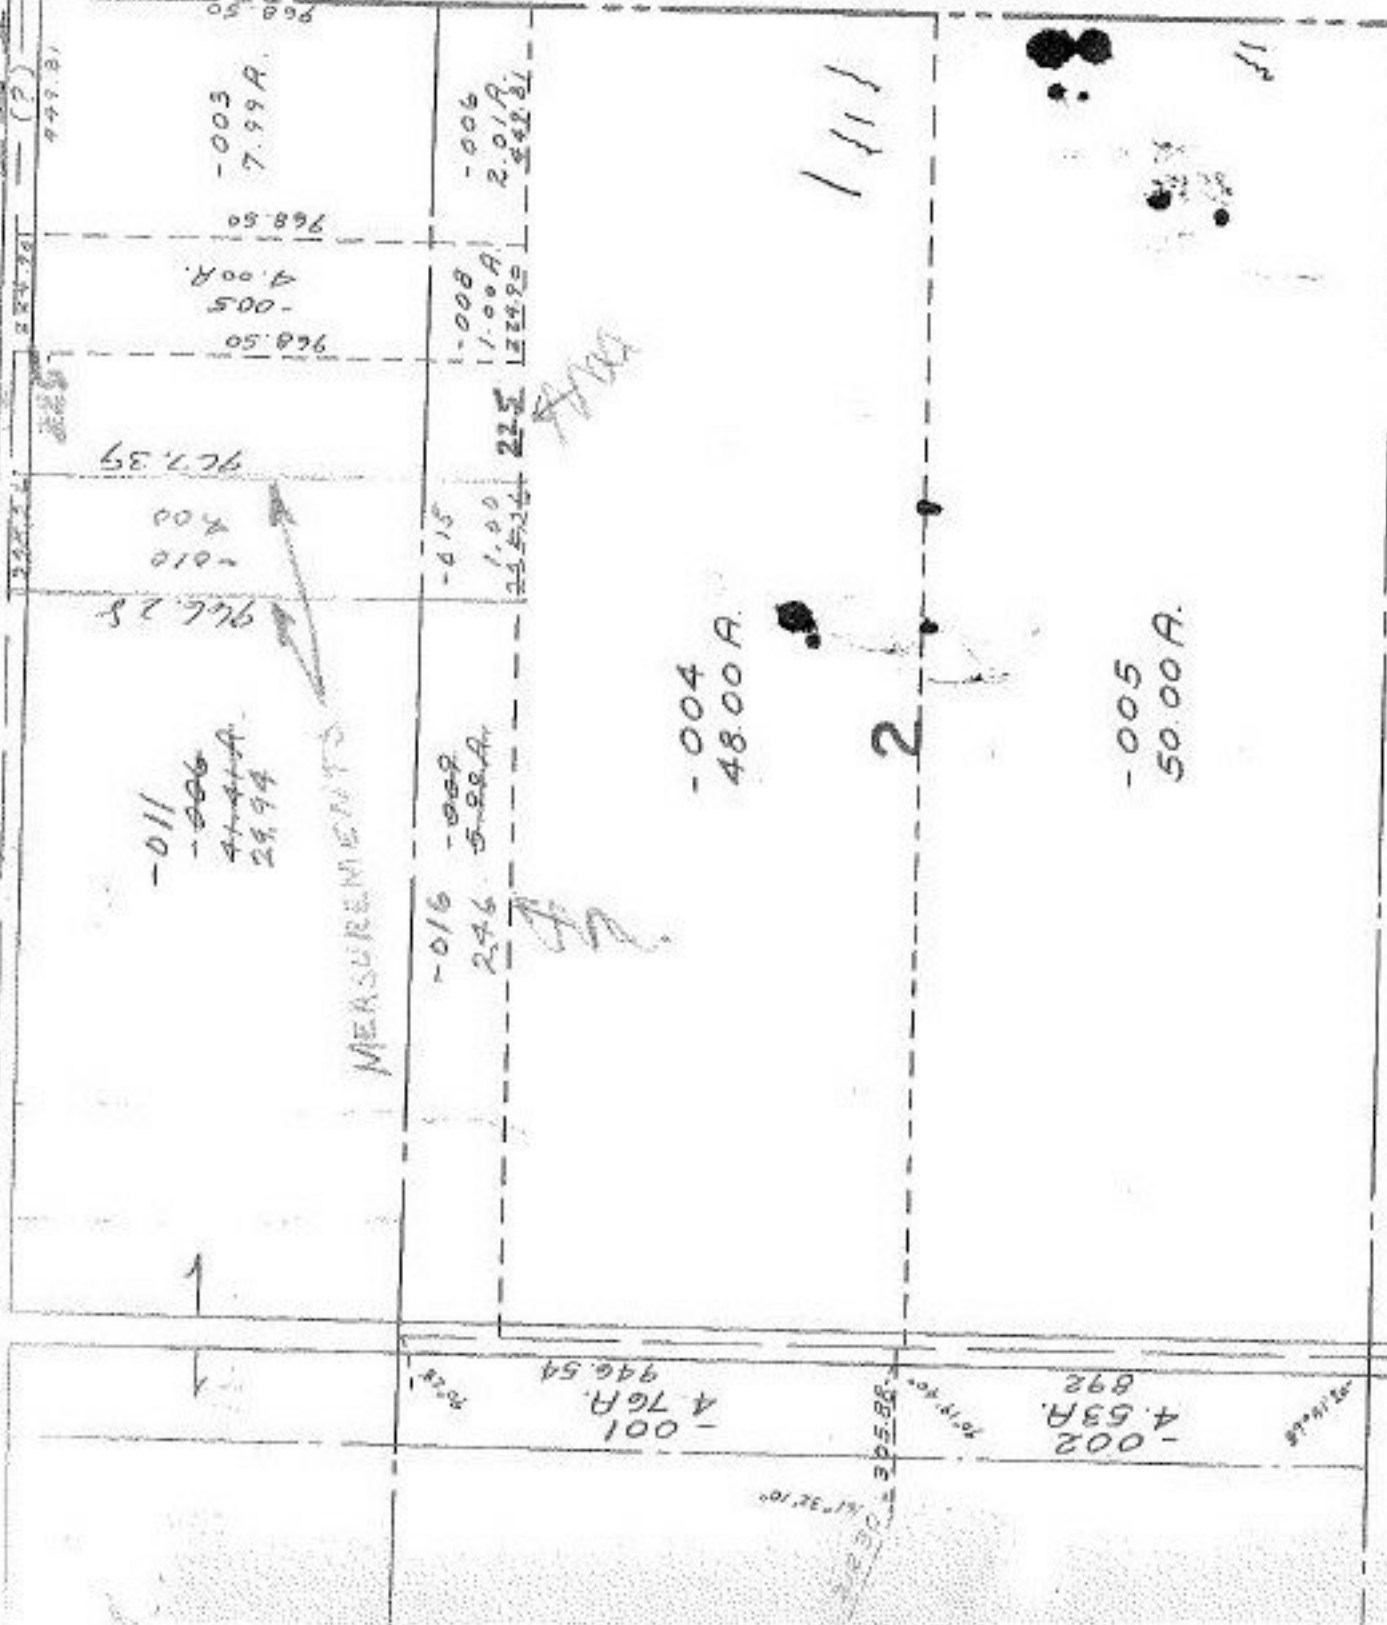

4113

APPROVED
LORAIN CO.
MAP DEPT.
DATE 7/21/70
BY ZAD
R. J. Kelling

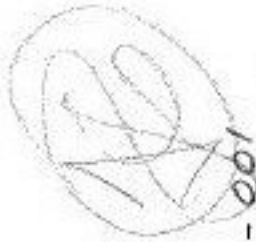

QUARRY

LWK Done on Maps 8-13-70 Pg 200