

4115




4115

SEE

APPROVED  
 LORAIN CO.  
 MAP DEPT.  
 DATE 7/21/70  
 3-00-004-A  
 BY R. V. Kellner

3-00-004-A

17.77  
6.3  
17.14

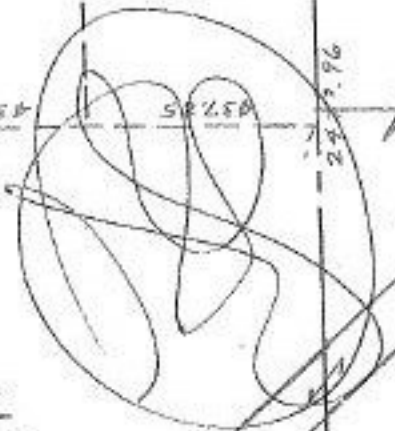

Done on Map from 70

Pg 3-00004A



17.77  
6.3  
17.14

22.13  
14.2  
17.77

423.38  
420.42  
120.42

437.25

437.58

999.90

997.90  
1244.1

-012  
12.50 A.

1244.1

247.96

437.85

437.96

227.5

155.7  
126.9  
-004  
-004  
355.1

579.58  
250.05  
245.82

572.78  
-053  
MSA

257.38

C

X

N

PT. -030  
PT. 20.35 A.

PT. -026  
PT. 5.12 A.

PT. -024  
PT. 19.56 A.

4



1324