


4121

4121



-006
8.00A

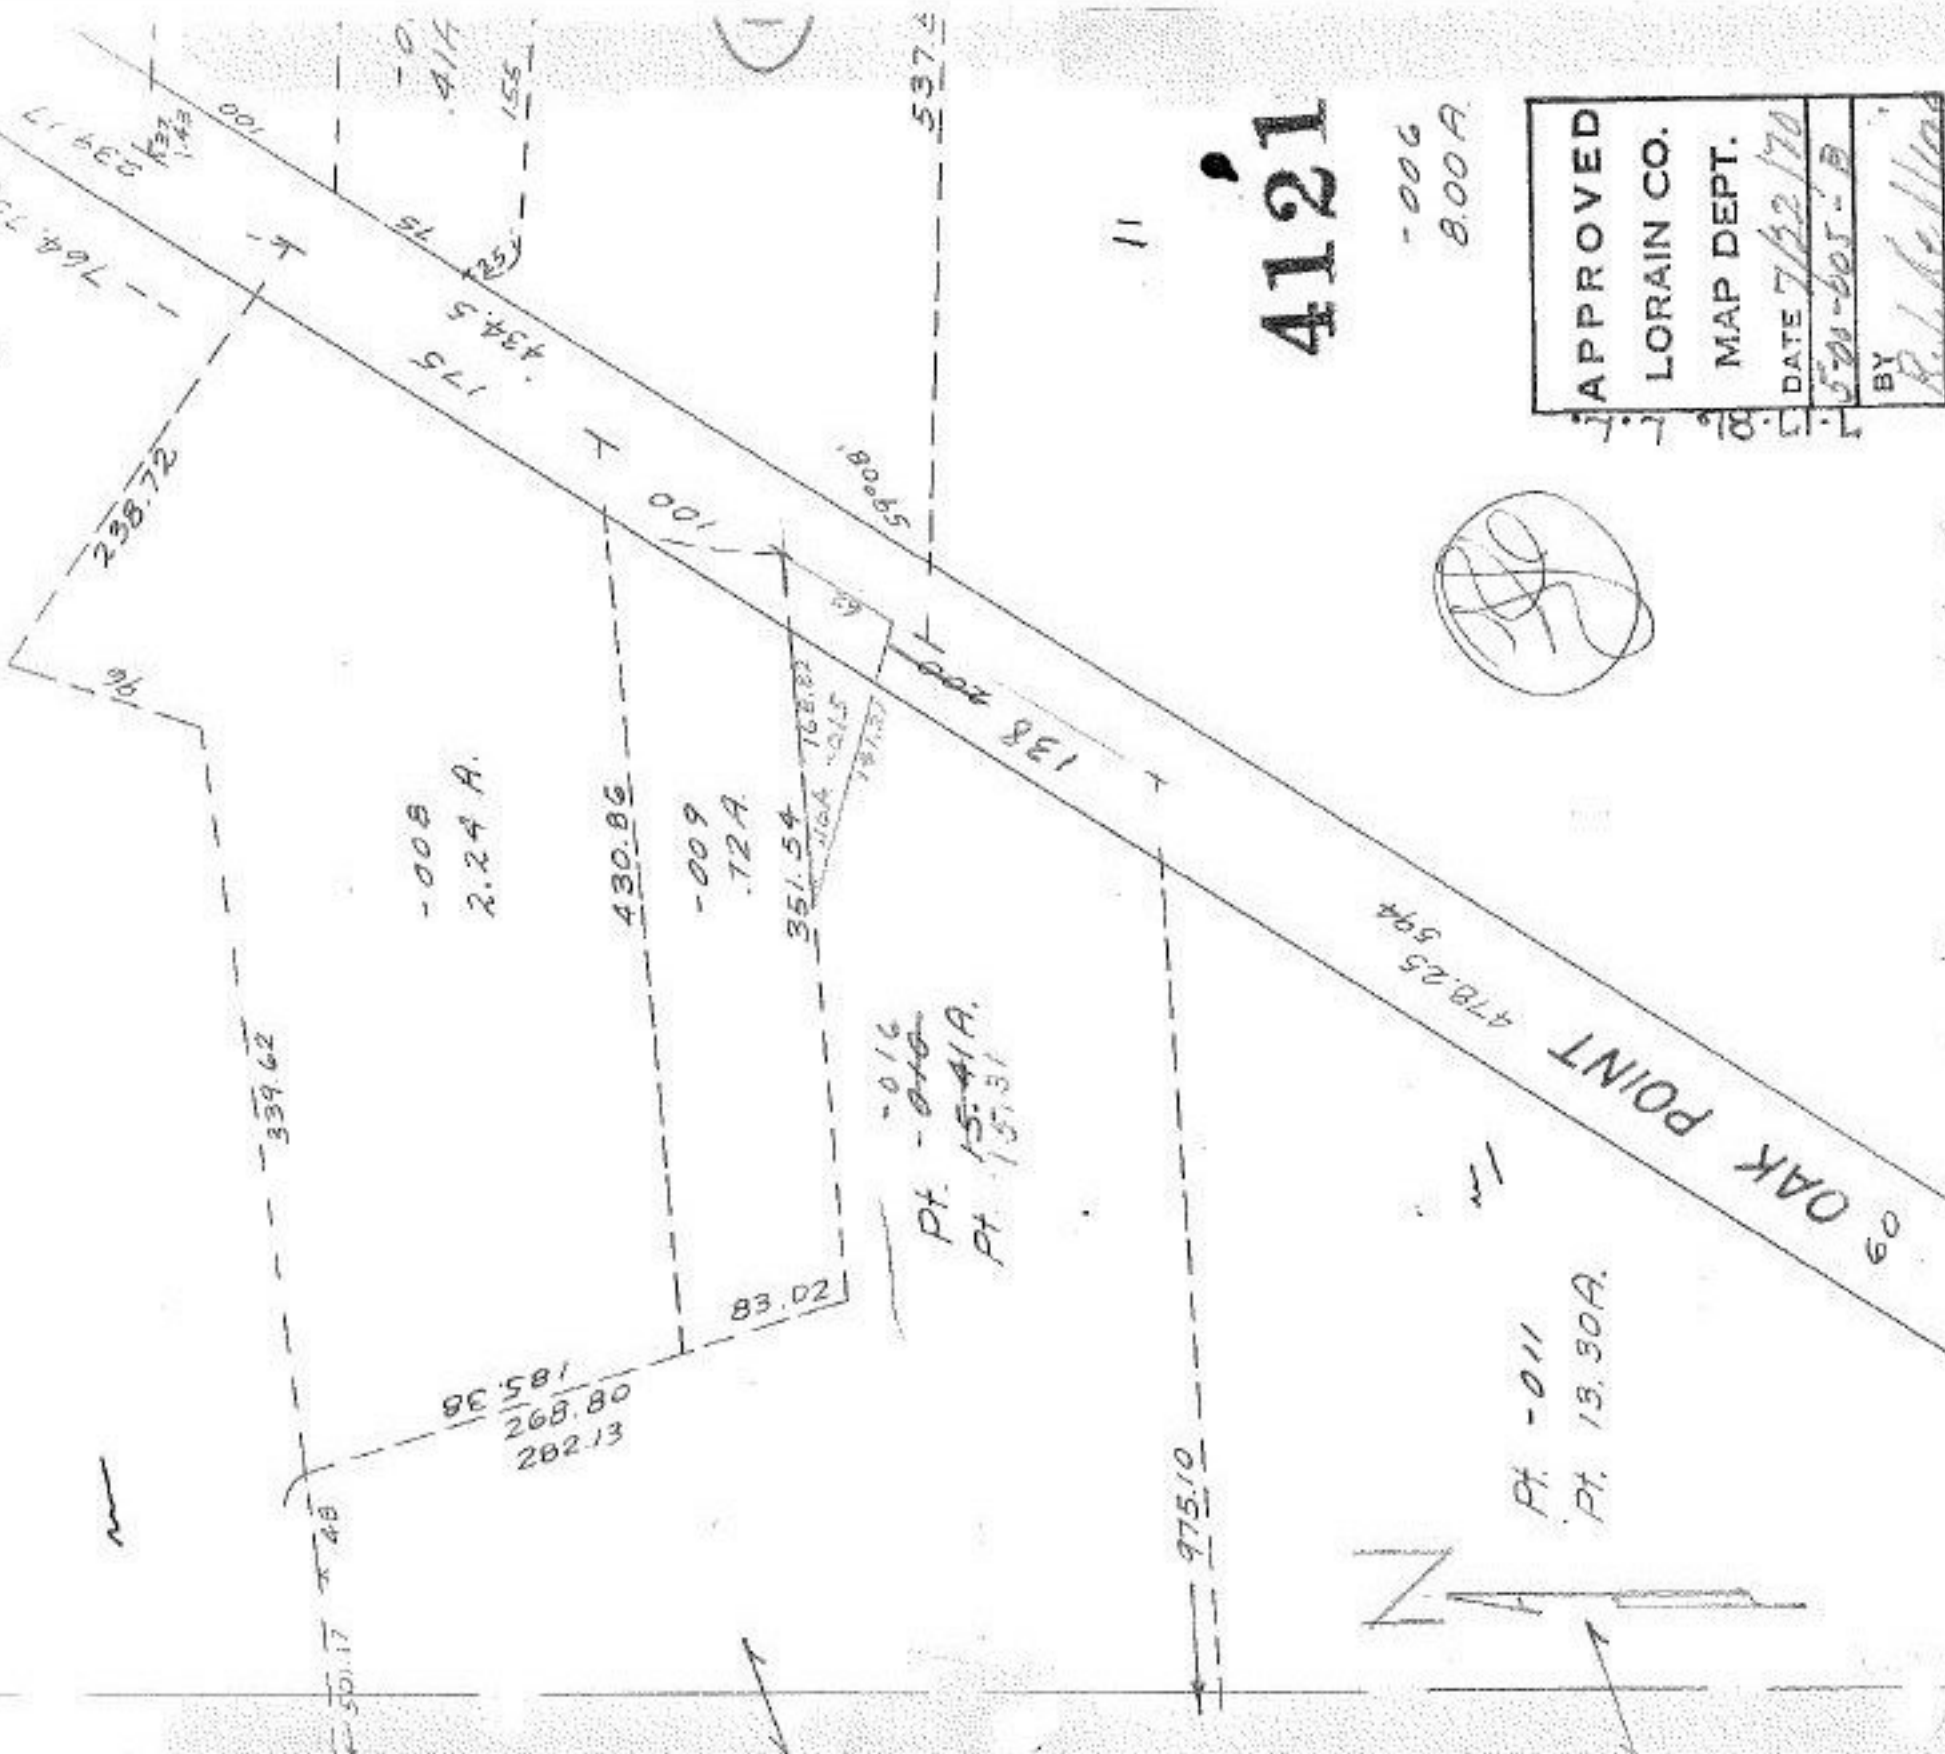

Pt. -011
Pt. 13.30A

APPROVED
LORAIN CO.
MAP DEPT.
DATE 7/22/70
BY R. L. Keenan

1580.22 Dope on Maps & 14-70 L.M.A.

Pg 5-00-005B

SEE 5-00-006-B