


4131



Pt. -005  
Pt. 17.50 A.

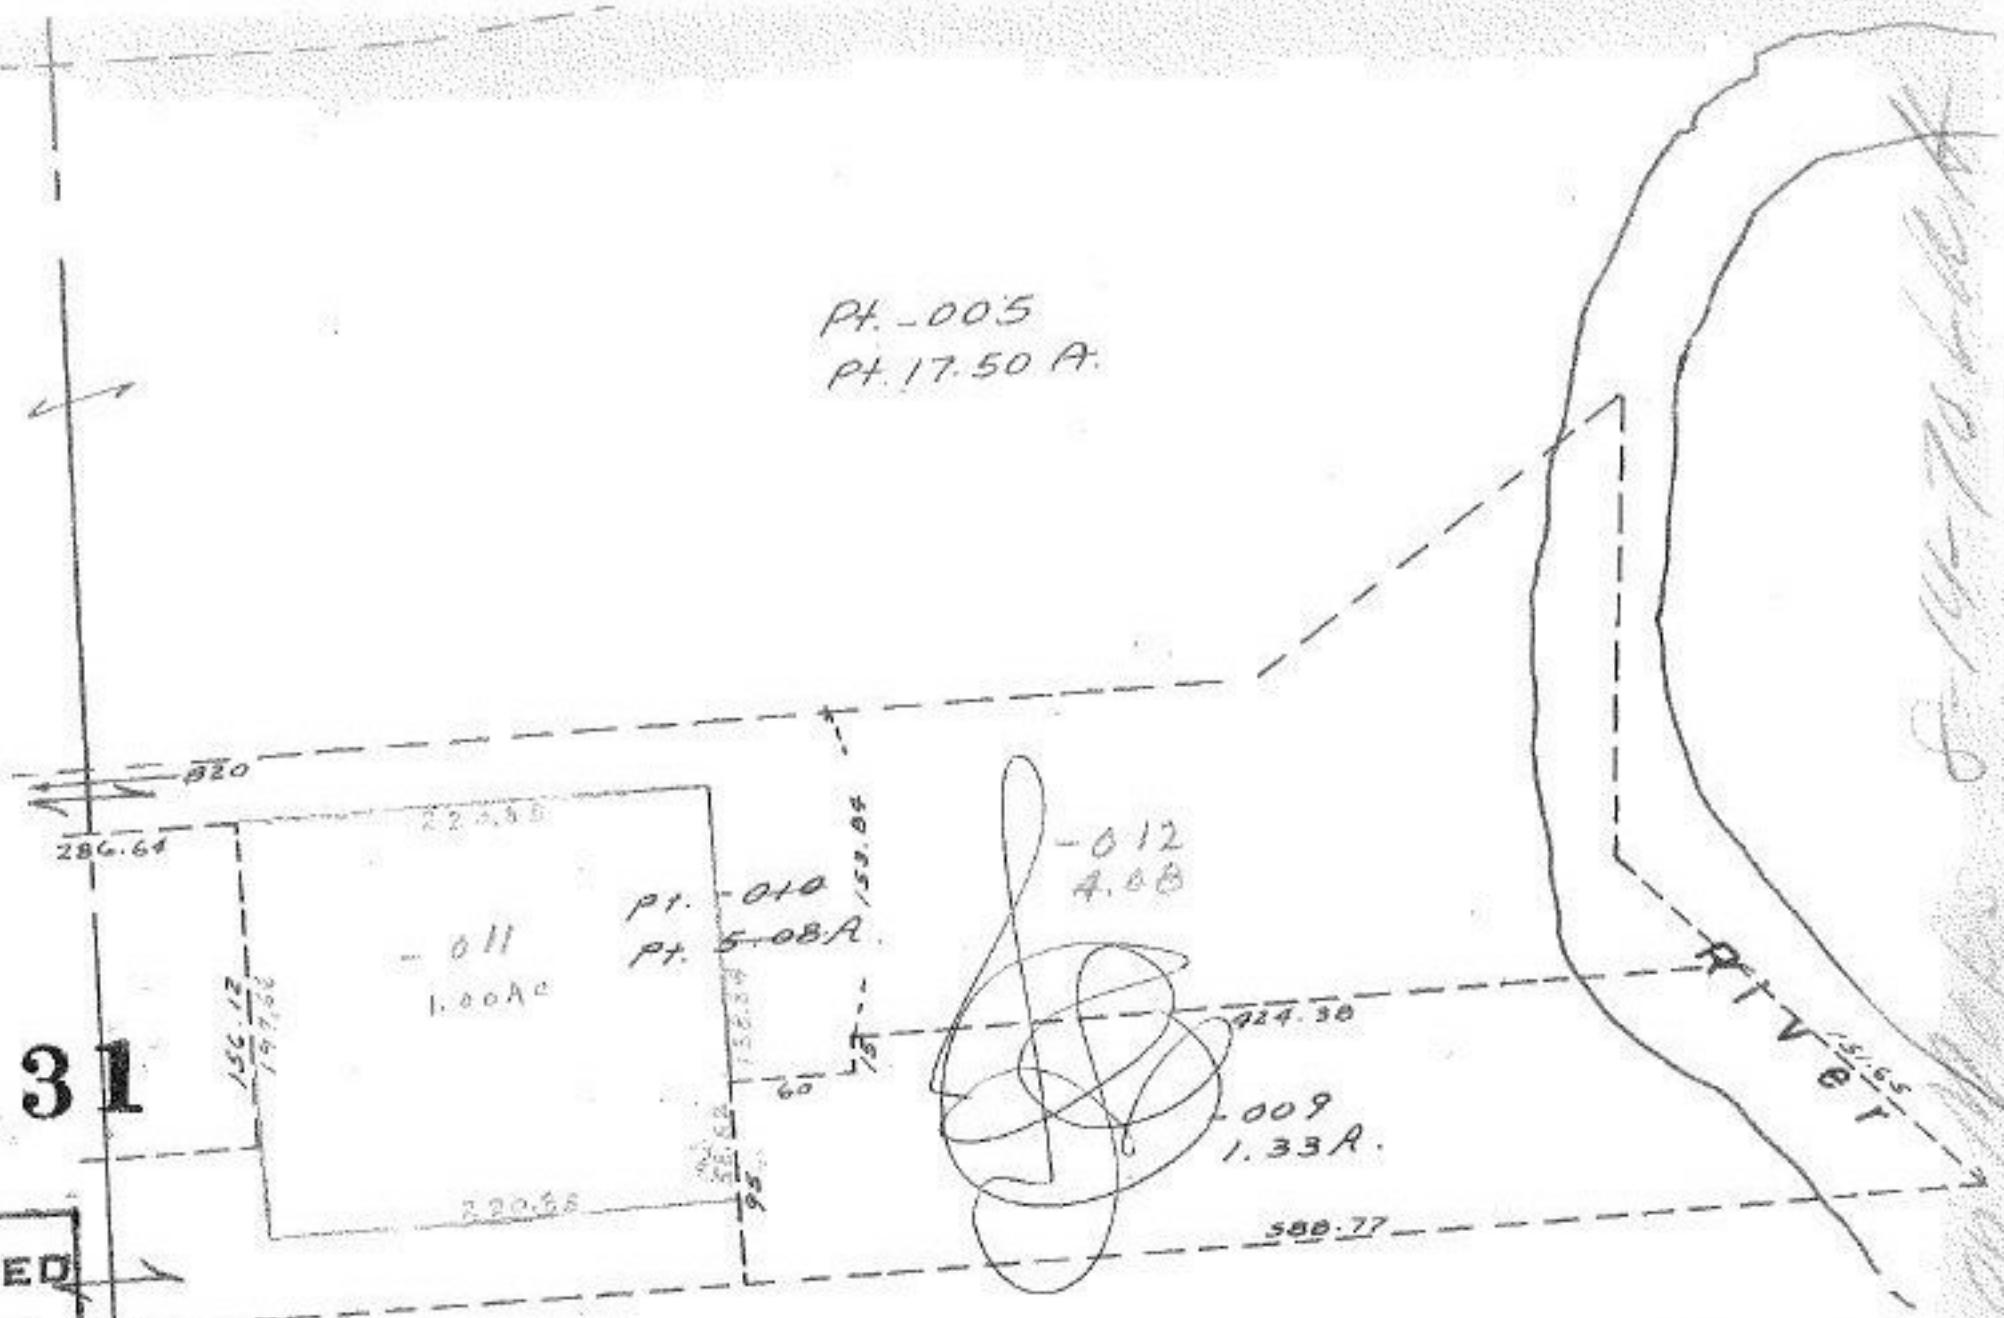

4131

APPROVED
LORAIN CO.
MAP DEPT.
DATE 7/27/71
BY R. J. K. King

98-59

SEE 10-00-0

CARLISLE TWP.

SCALE: 1" = 10'

4131

015-1

Handwritten notes and signatures on the right margin, including '8-14-70' and 'R. J. K. King'.