


SEE 10-00-013

301




679.06


520.64

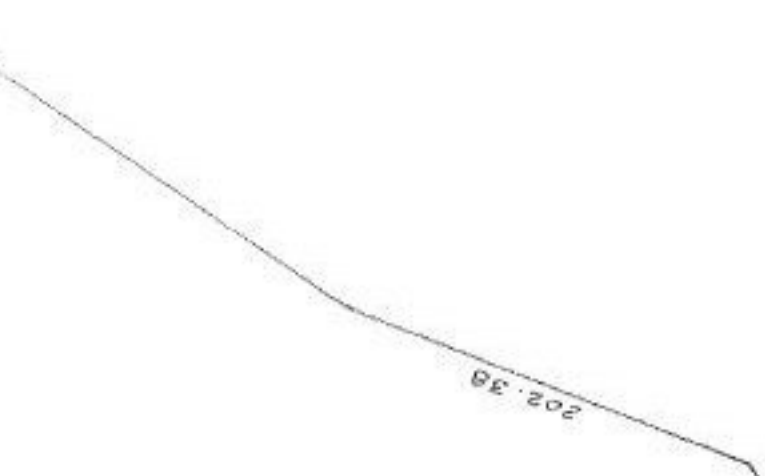

180.28

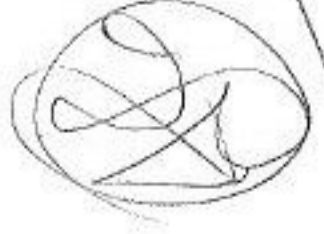

161.74

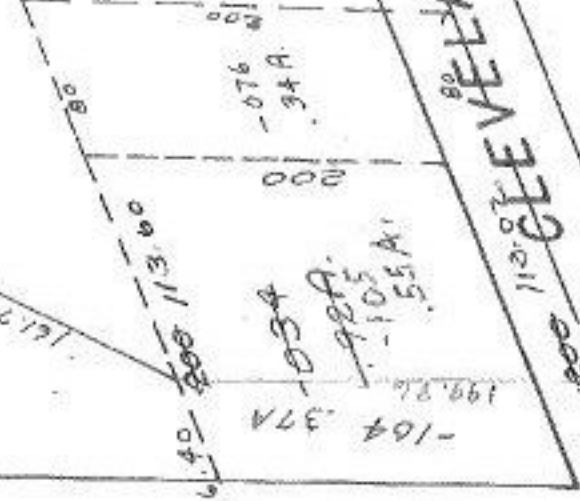

200.12

~~OBERLIN AUG 21 ENTD~~

~~GLEVELAND~~

723-86

55

200.00

86.45

200.00

86.02

DATE 8/6/70

10-00-013-2

BY

*Paul H. ...*

APPROVED

LORAIN CO.

MAP DEPT.

7-11-70

DATE 8/6/70

10-00-013-2

BY

*Paul H. ...*