


APPROVED
 LORAIN CO.
 MAP DEPT.
 DATE 8/10/20
 BY

2-01-003-

153,000 sq ft
 1/425602
 3,520 AC

Box 115	9200
150x130	83400
160x130	3900
136x180	2700
140x210	4200
140x250	119,000
53000	

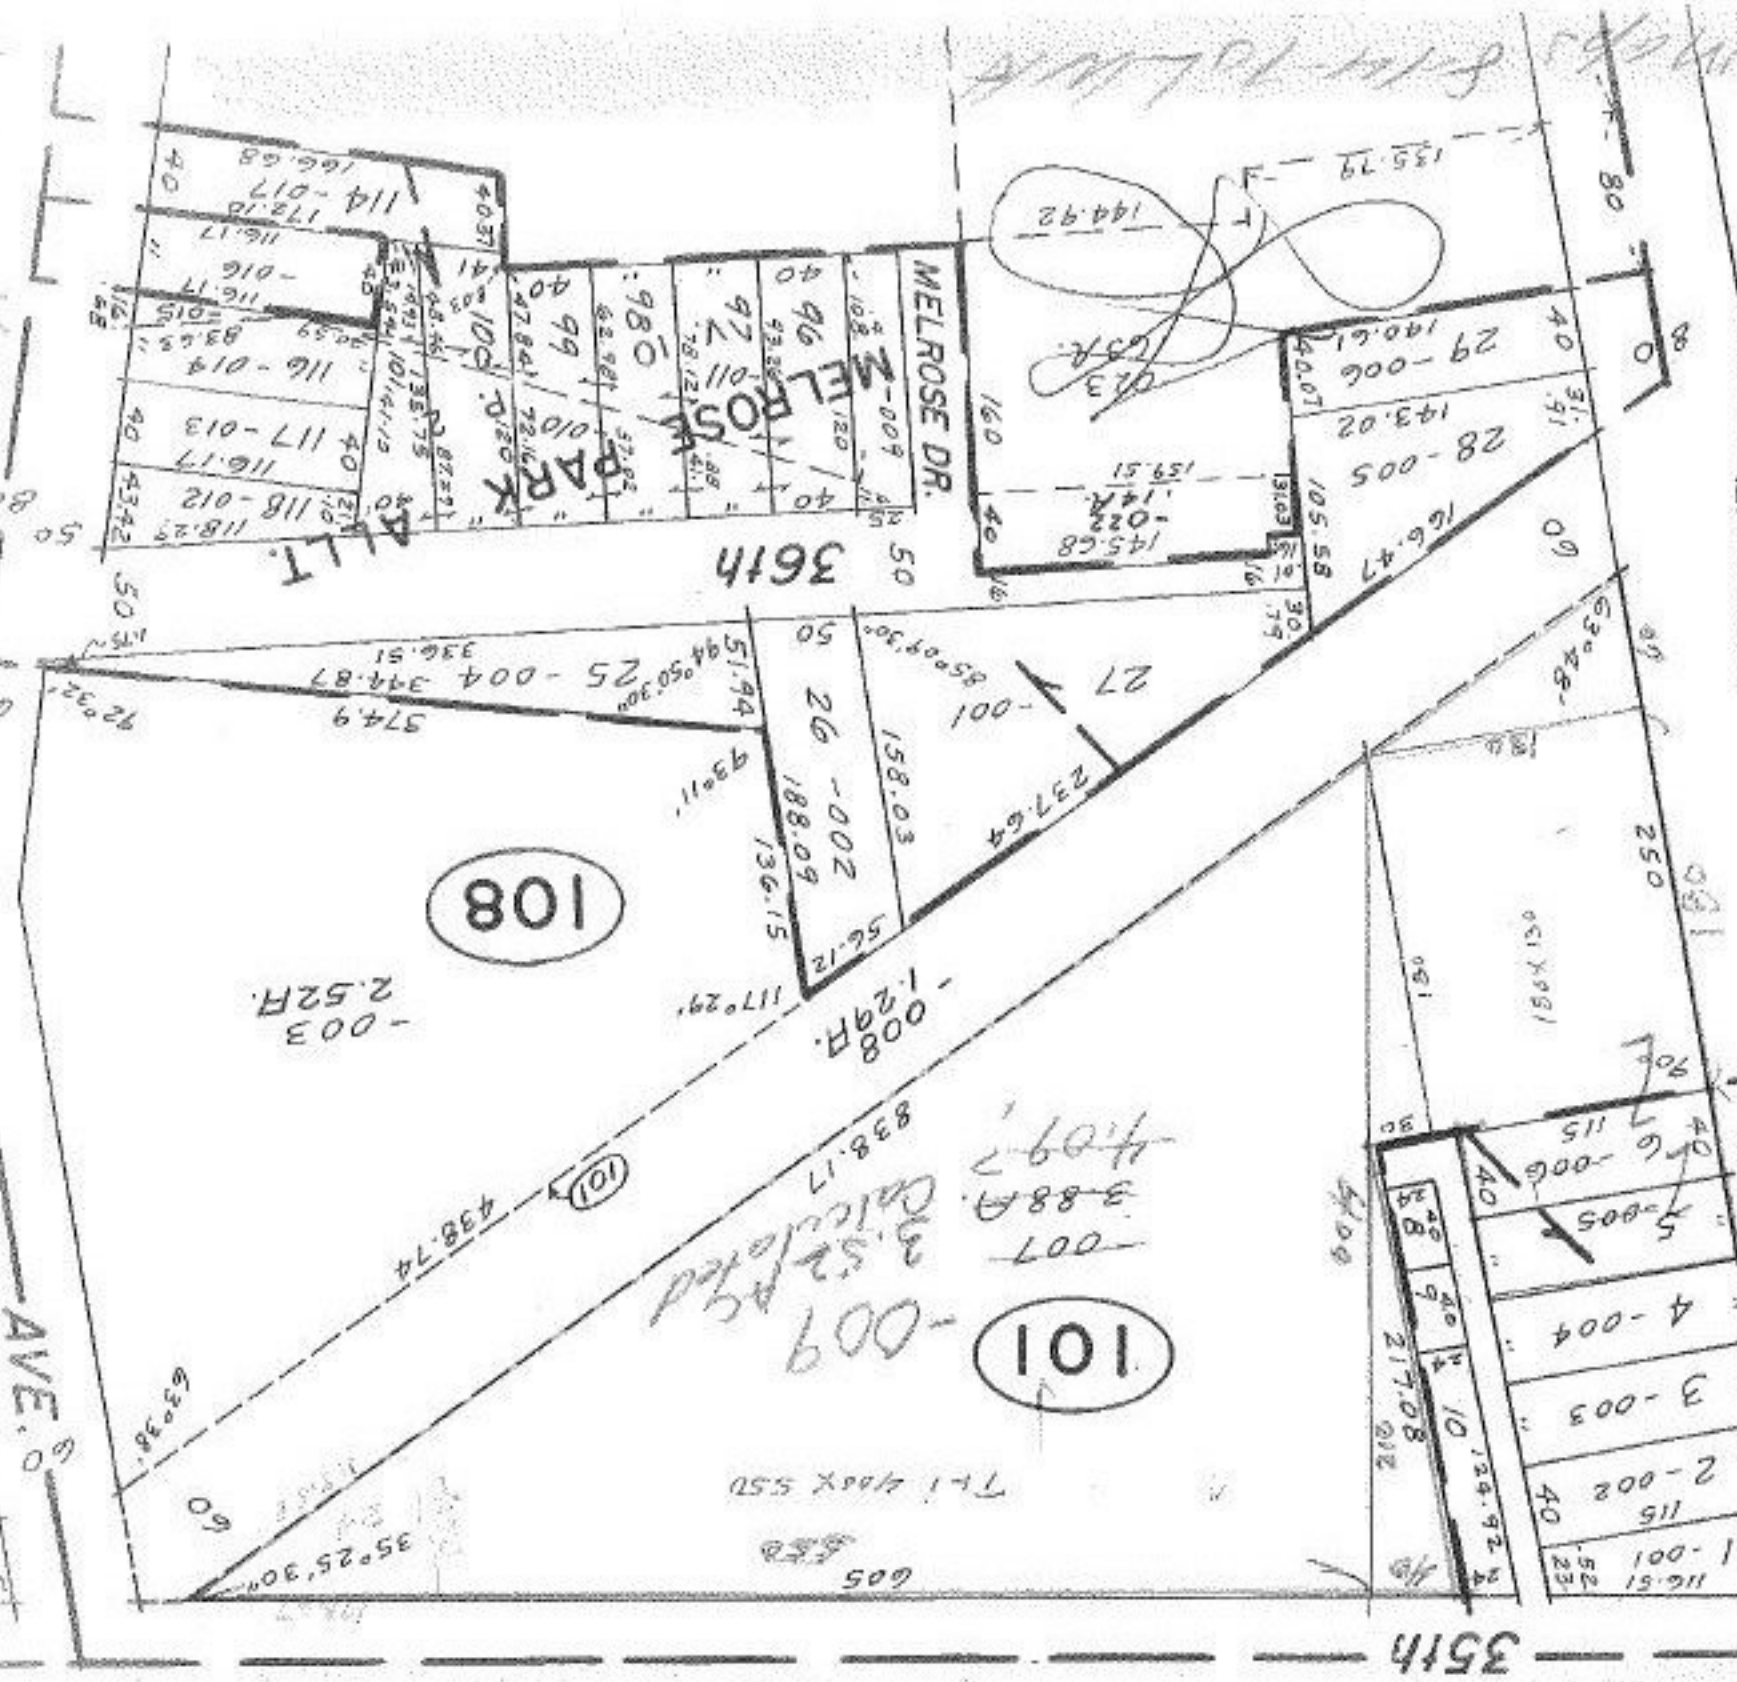

One on maps & in plat

AVE. 6

101

108

35th

4189

SEE 3-00-098-A 4189