


#4195

3-00-095-B



SEE 3-F

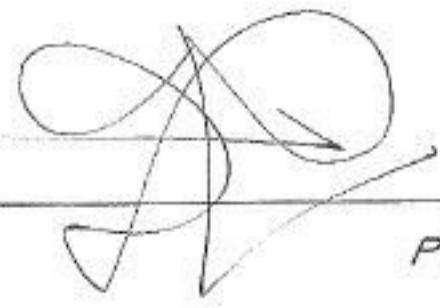

Pt. 03-00-083-101-006  
Pt. 806A.

*combined  
Towers*

3-00-095B

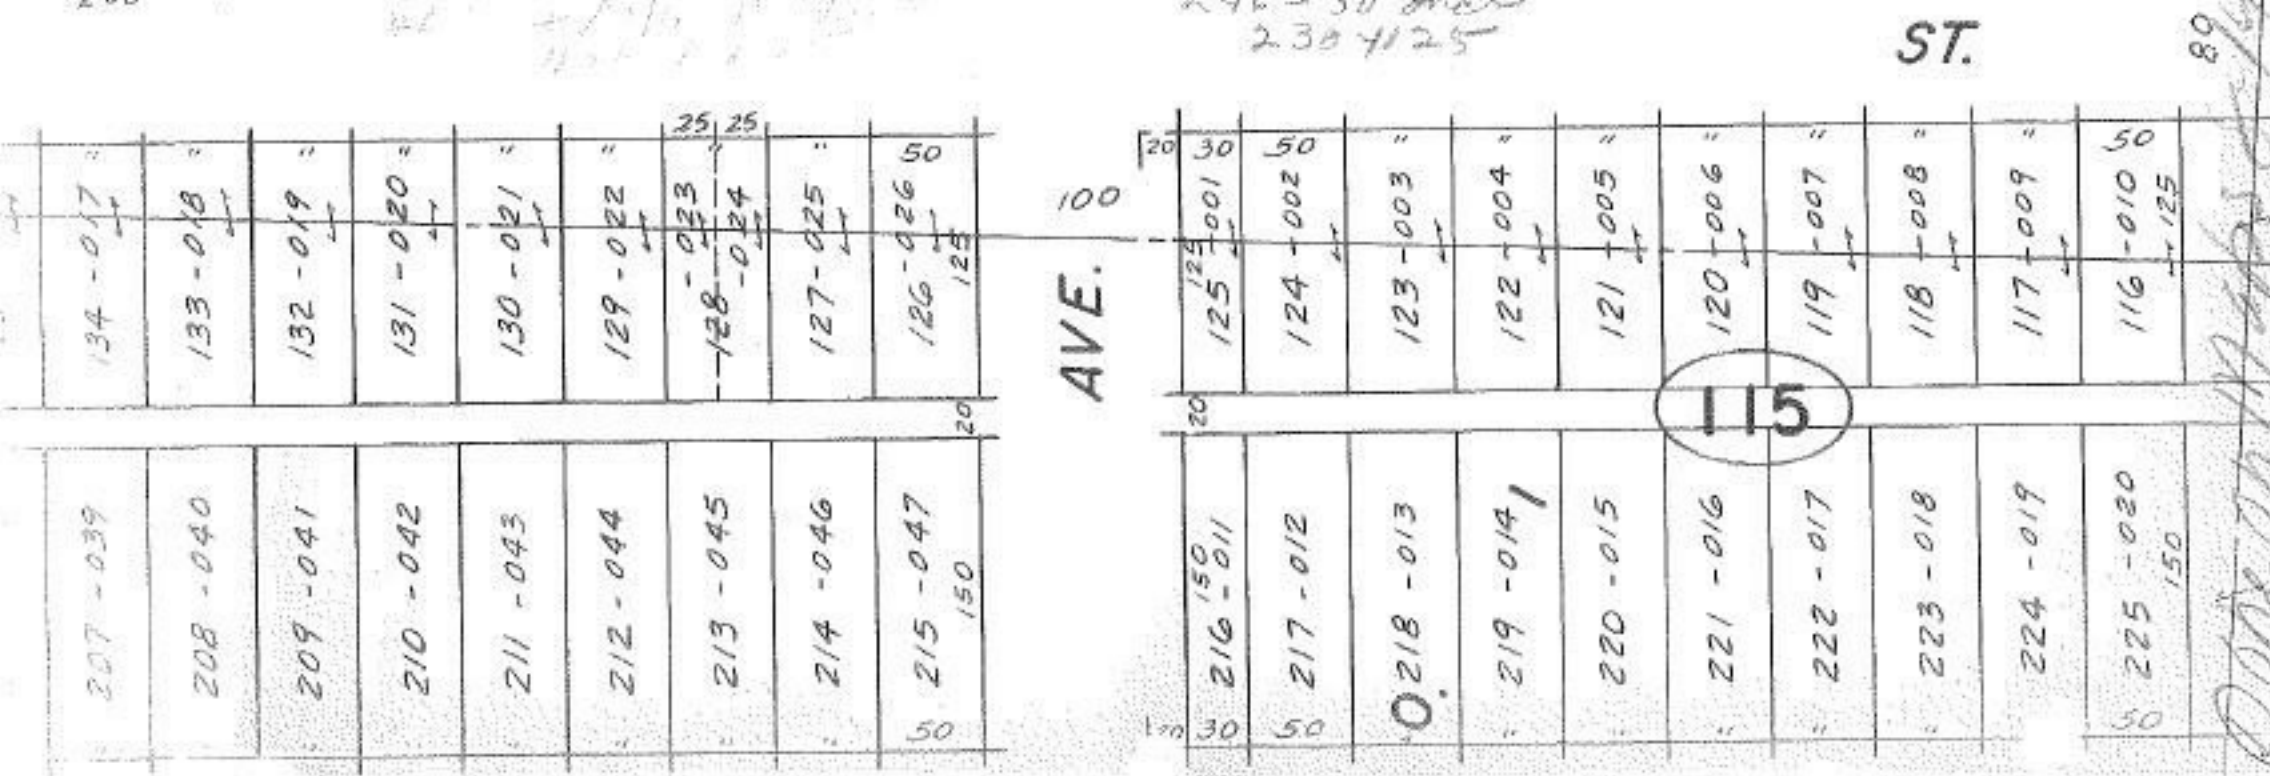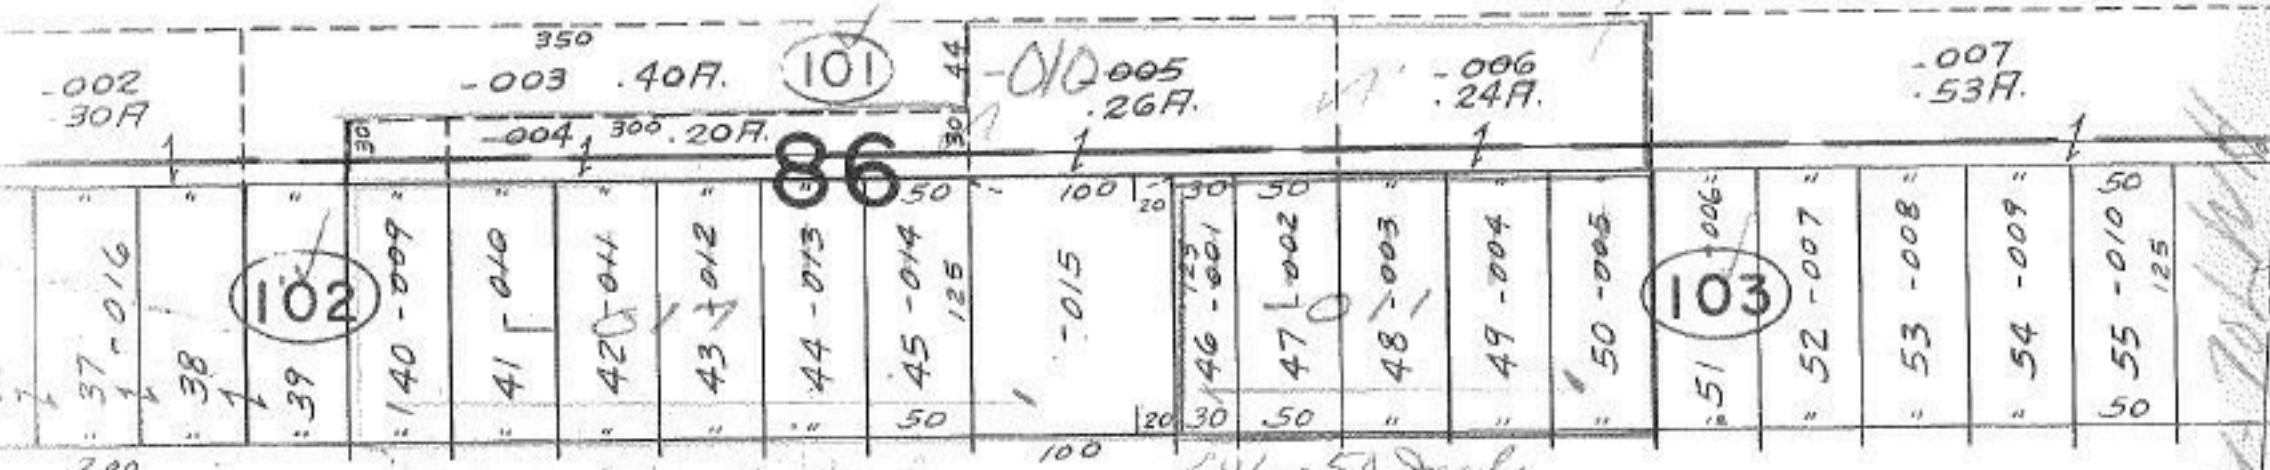

Done on 11/14/80