


4249

APPROVED
 LORAIN CO.
 MAP DEPT.
 DATE 8/27/70
 87-00-006-17
 BY
 R. J. K. W. King

102

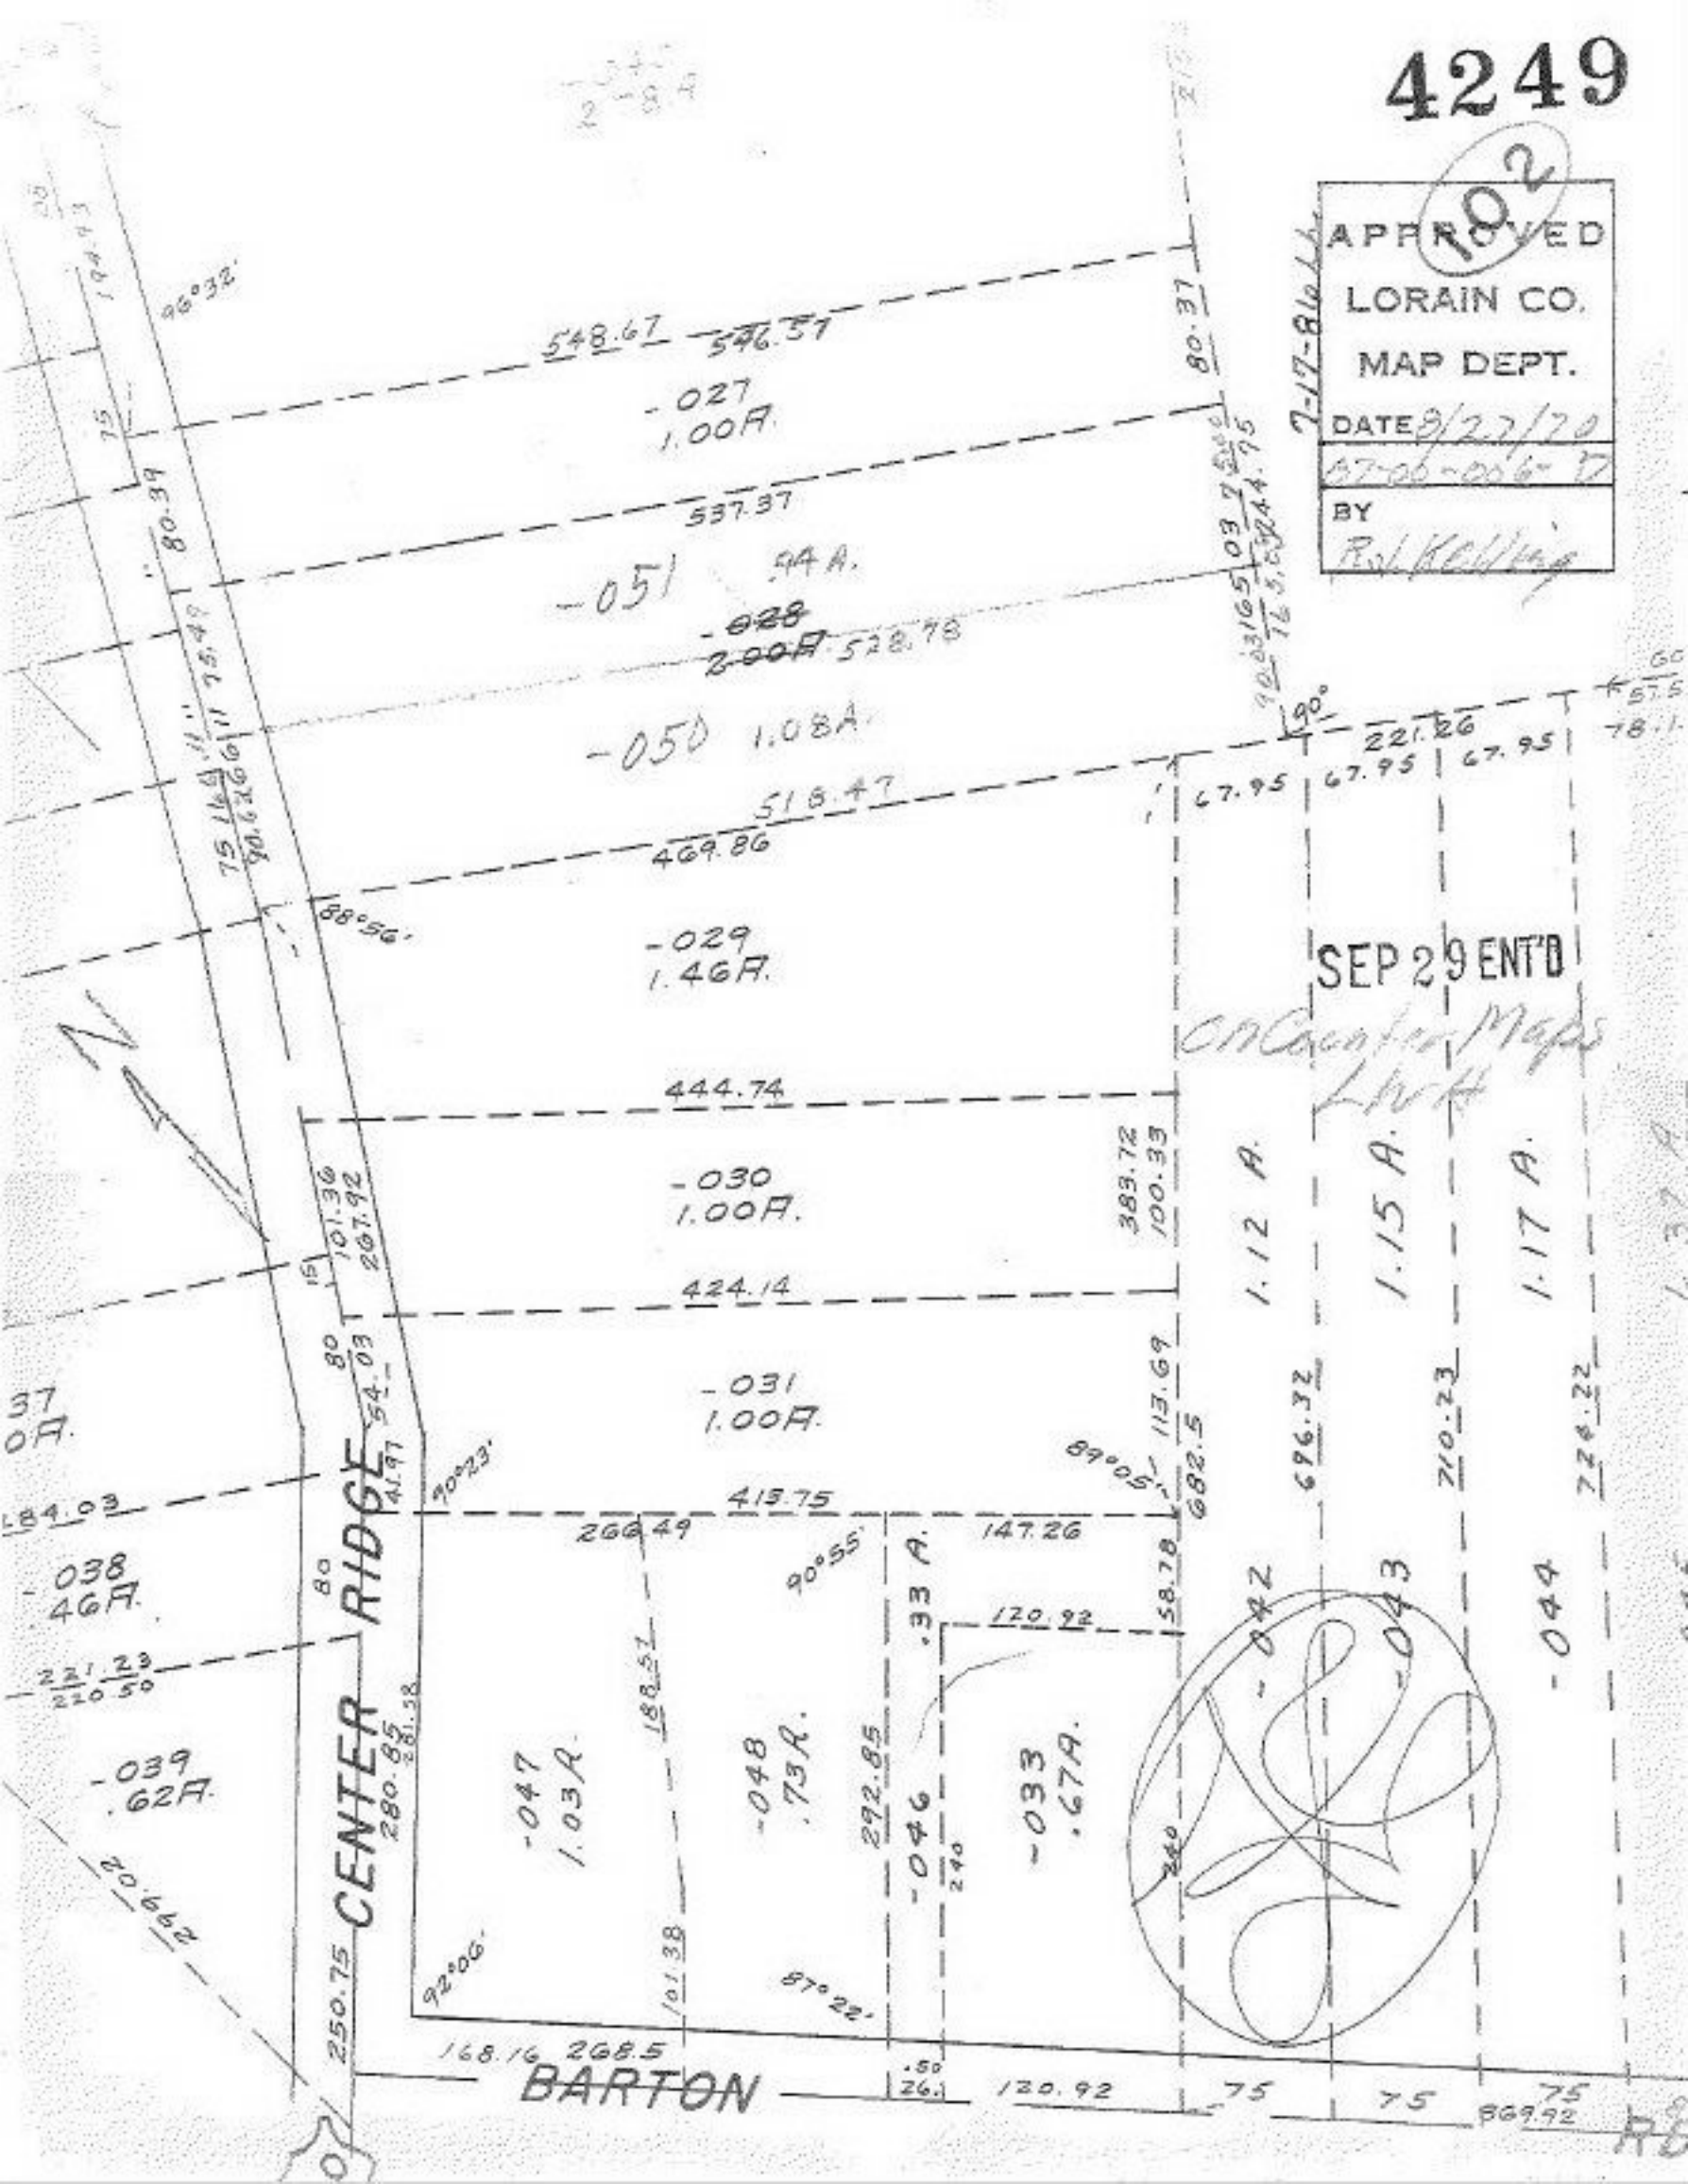

SEP 29 ENT'D

C. J. Coates Maps
L. W. H.

7-17-81

90.03/65 03 7.00 76.5.004.95

CENTER RIDGE

BARTON

