


4253

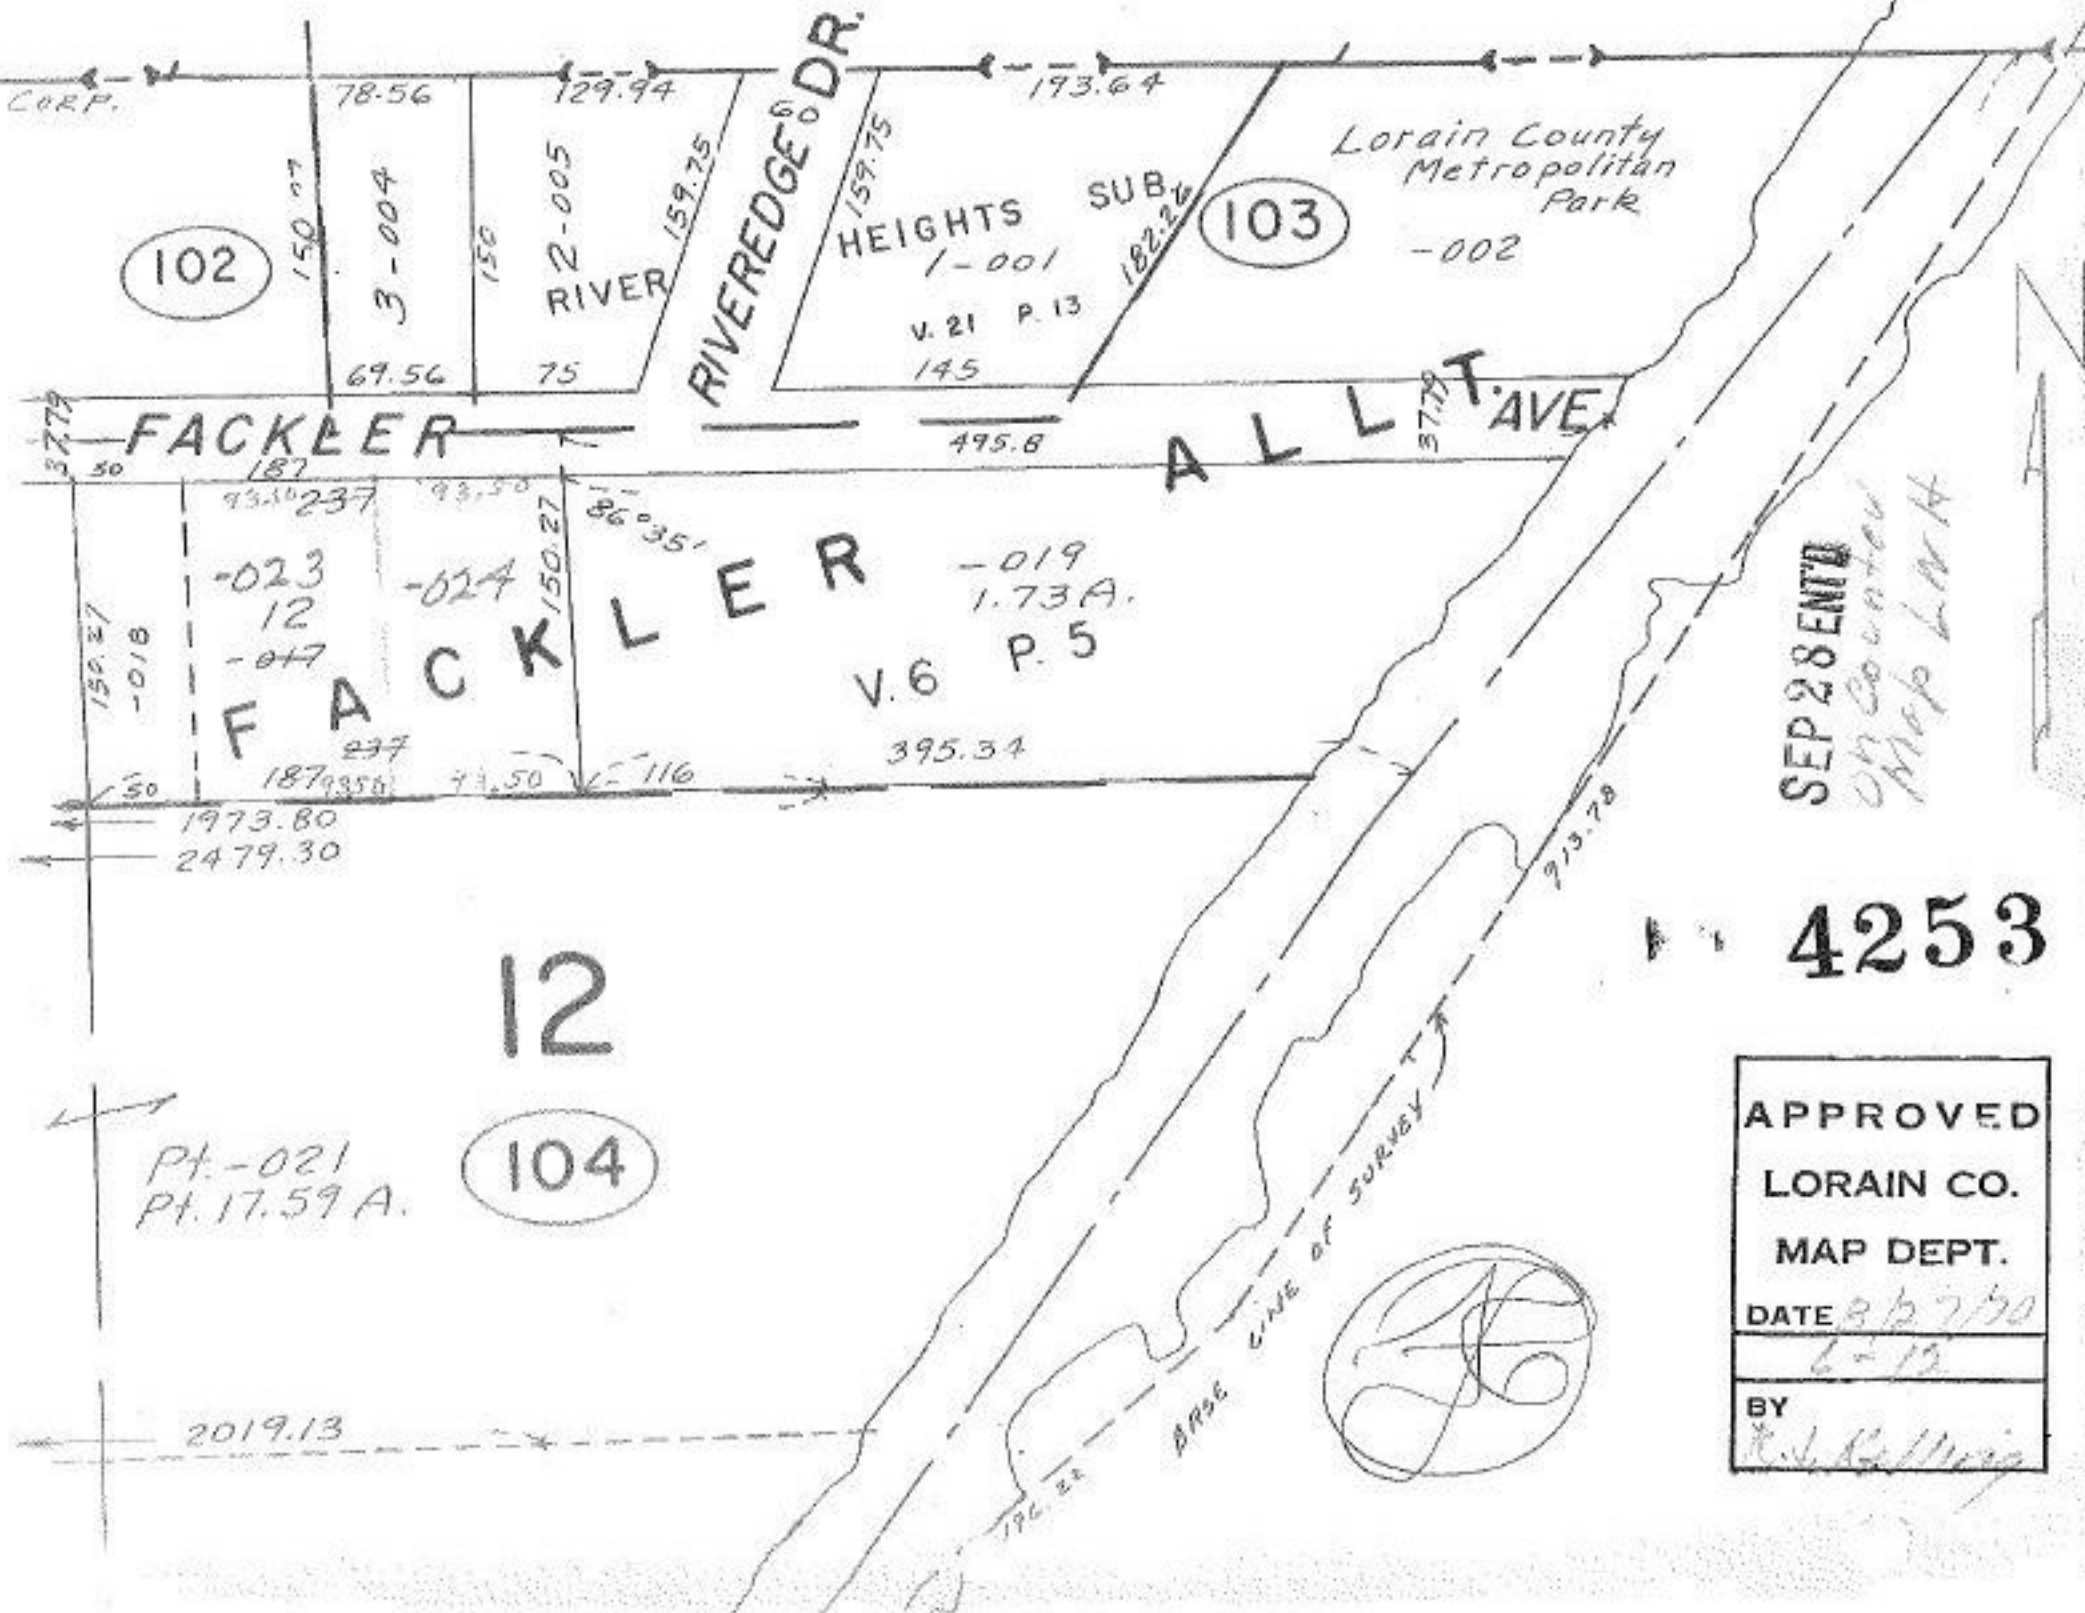

Lorain County Metropolitan Park

SEP 28 1950
On County Map L.M.H.

4253

APPROVED
LORAIN CO.
MAP DEPT.
DATE 8/27/50
6-12
BY
R. J. Bell

