


4257

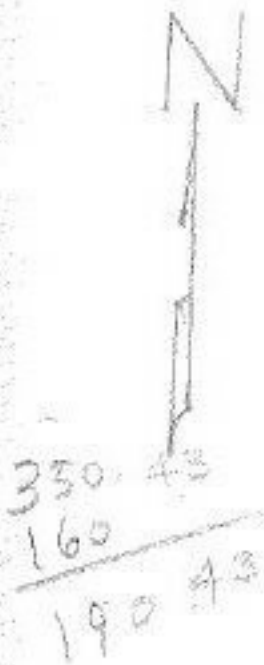


400.43
184.48
215.95

SEE 2-02-017-A

[Handwritten signature]

REEVES
E-524.99
C-49.16

RESUB NO. 7
V. 23
281-008
238.91

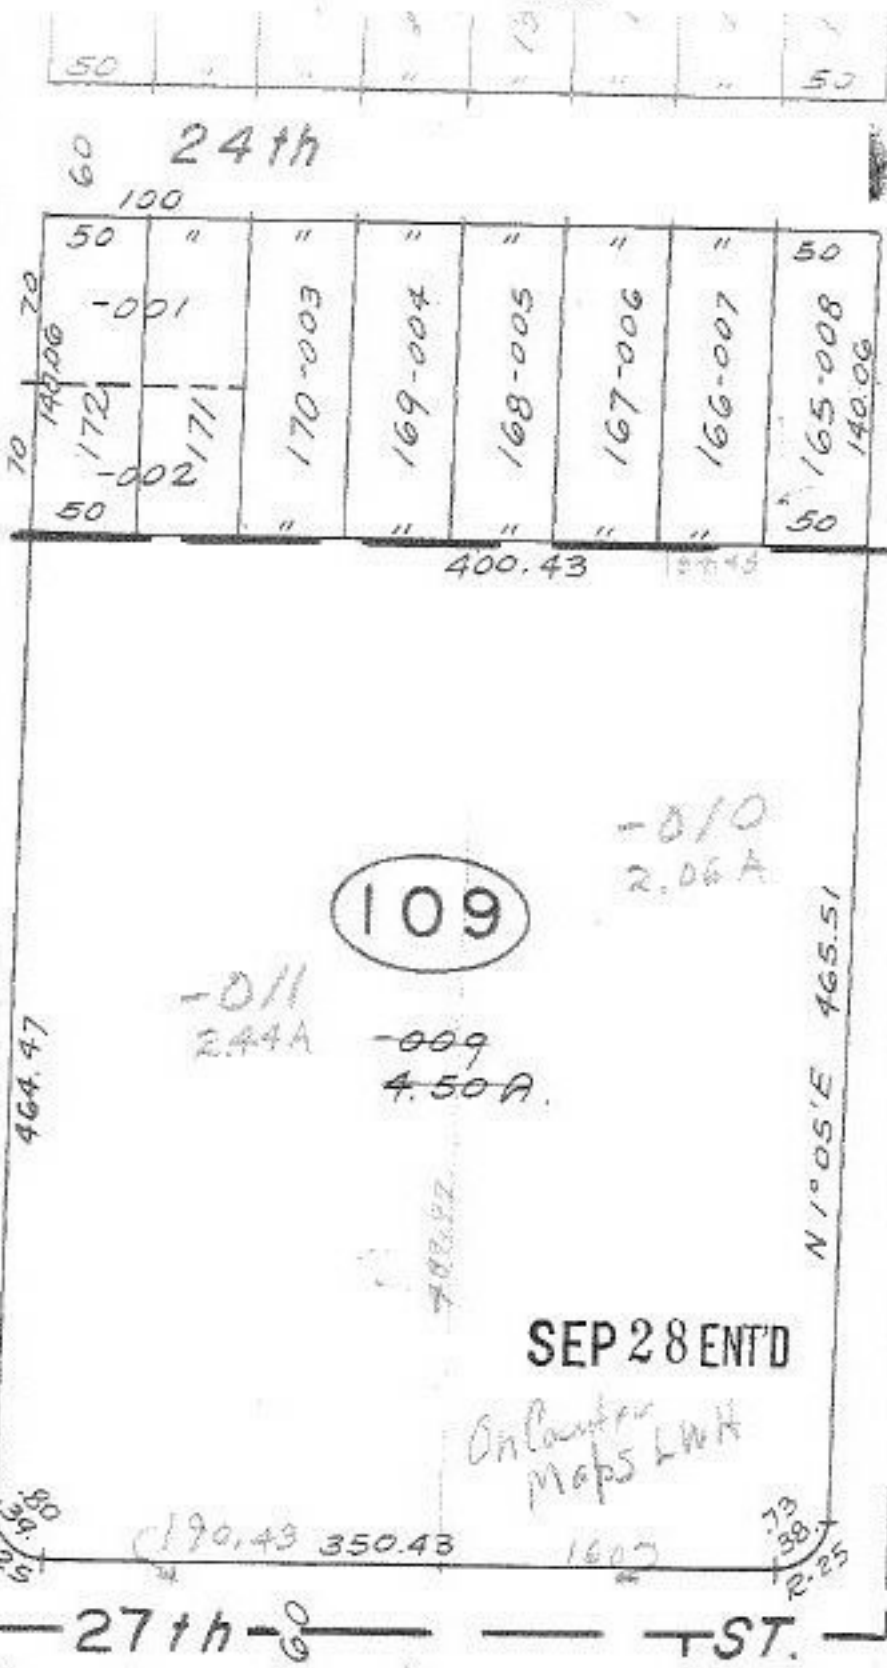

4257

APPROVED
LORAIN CO.
MAP DEPT.
DATE 9/27/76
BY
[Signature]

