
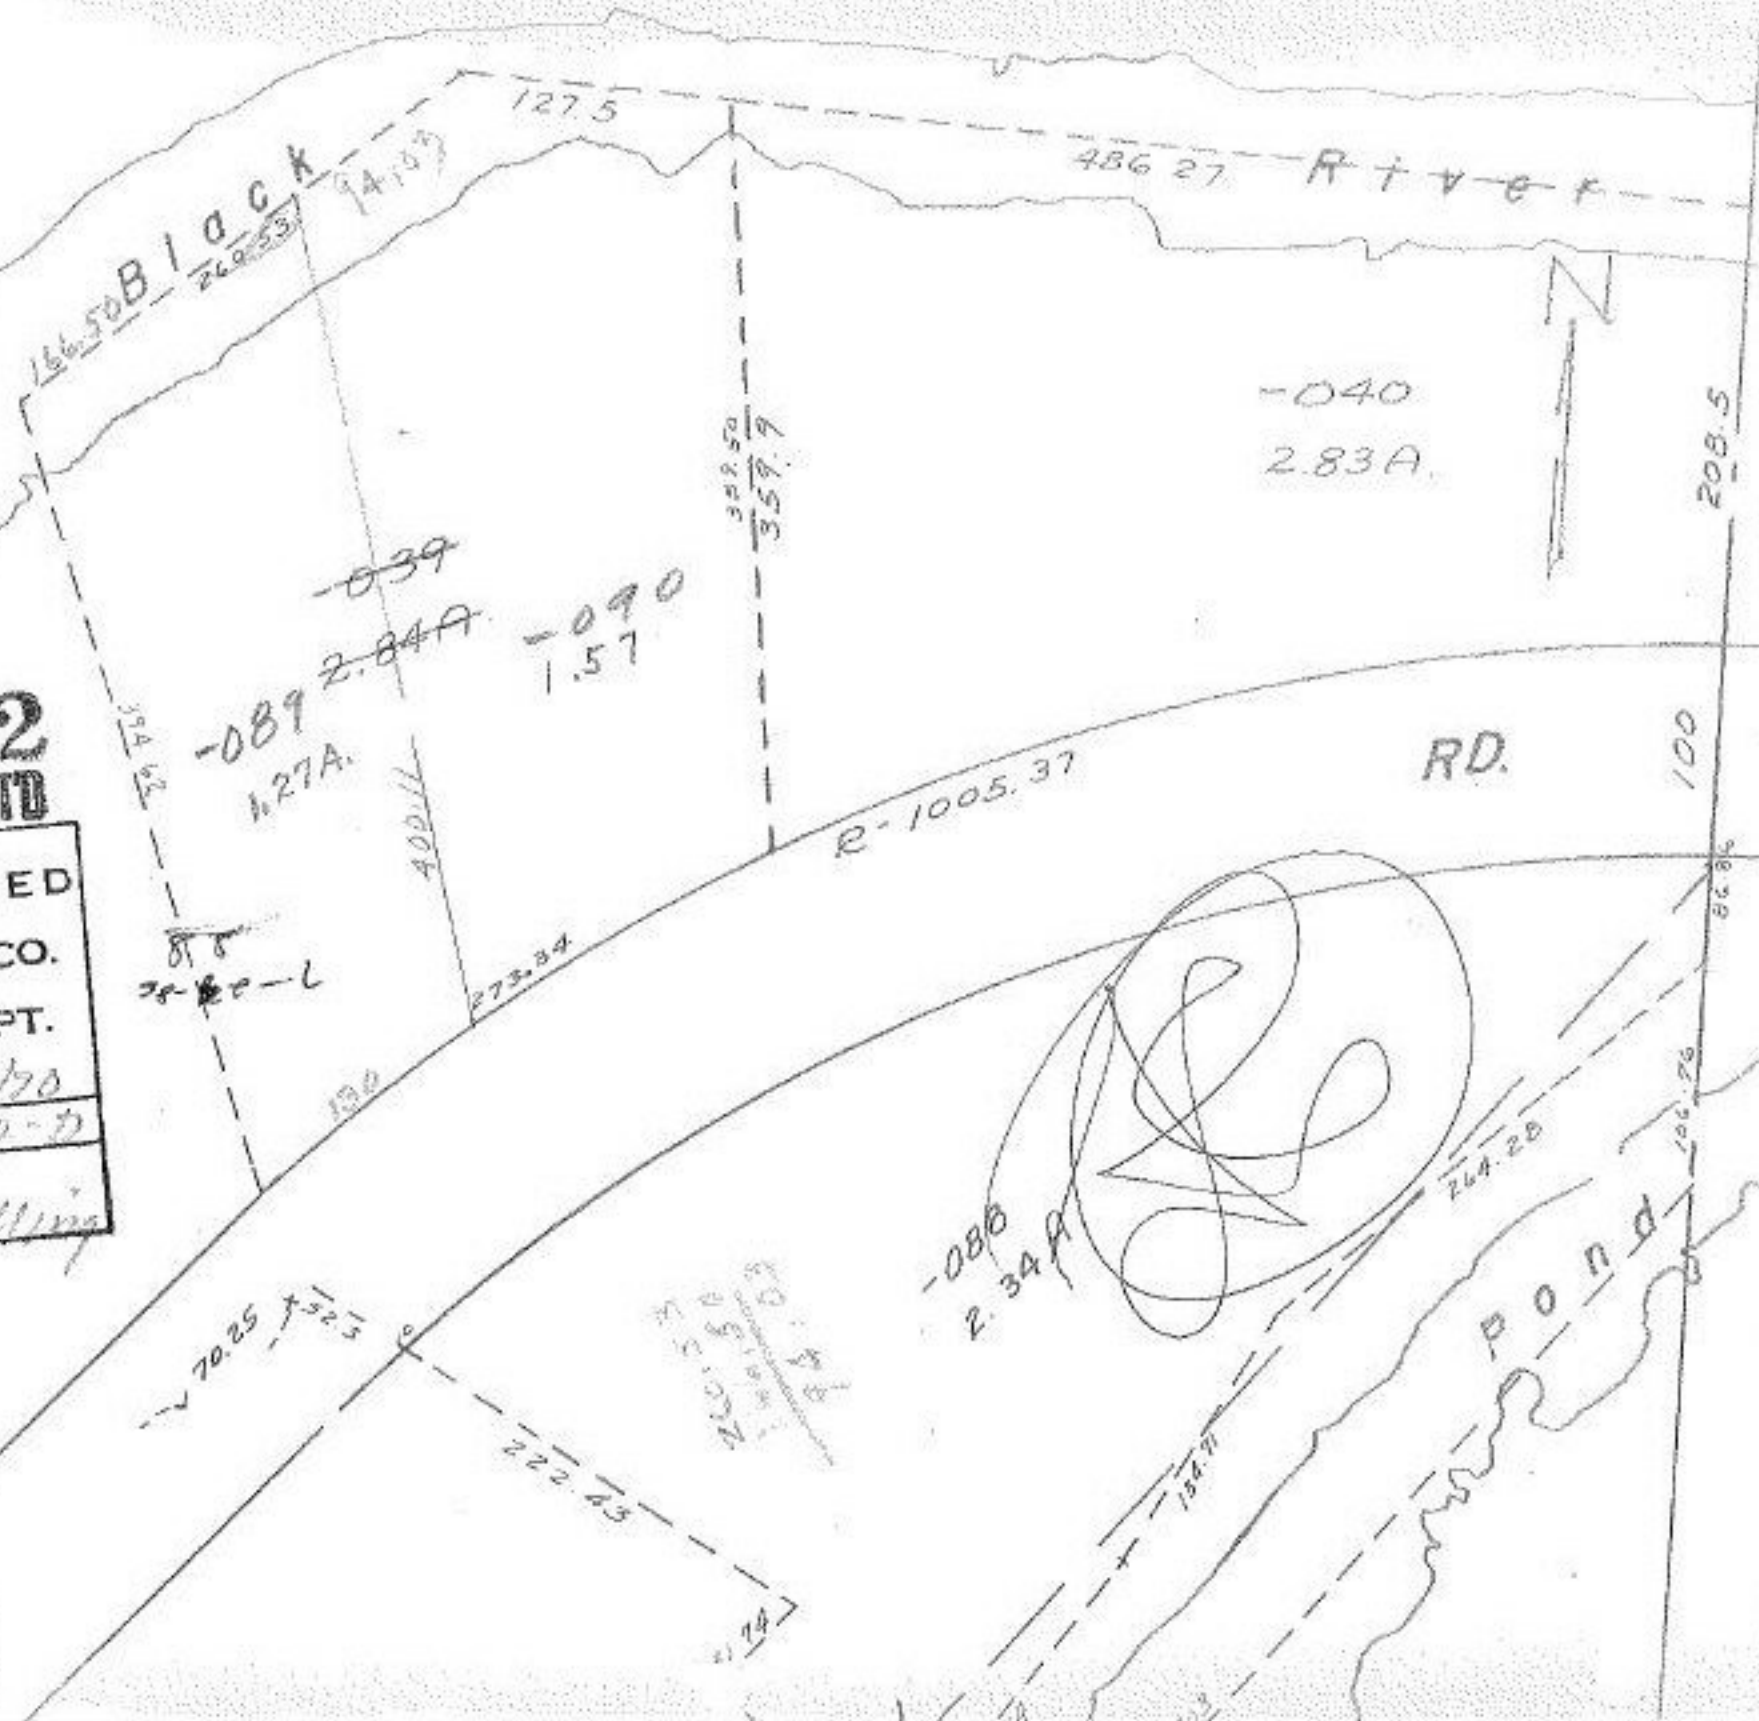


4272

4272
NOV 13 ENTD

APPROVED
LORAIN CO.
MAP DEPT.
DATE 9/2/70
18-00-012-D
BY R.J. Kelling

-038
36.63A

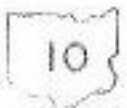

SEE 10-00-013-A