


4288

APPROVED
 LORAIN CO.
 MAP DEPT.
 DATE 9/16/70
 18-00-015-A
 BY
 Fred K. ...

P1
P1

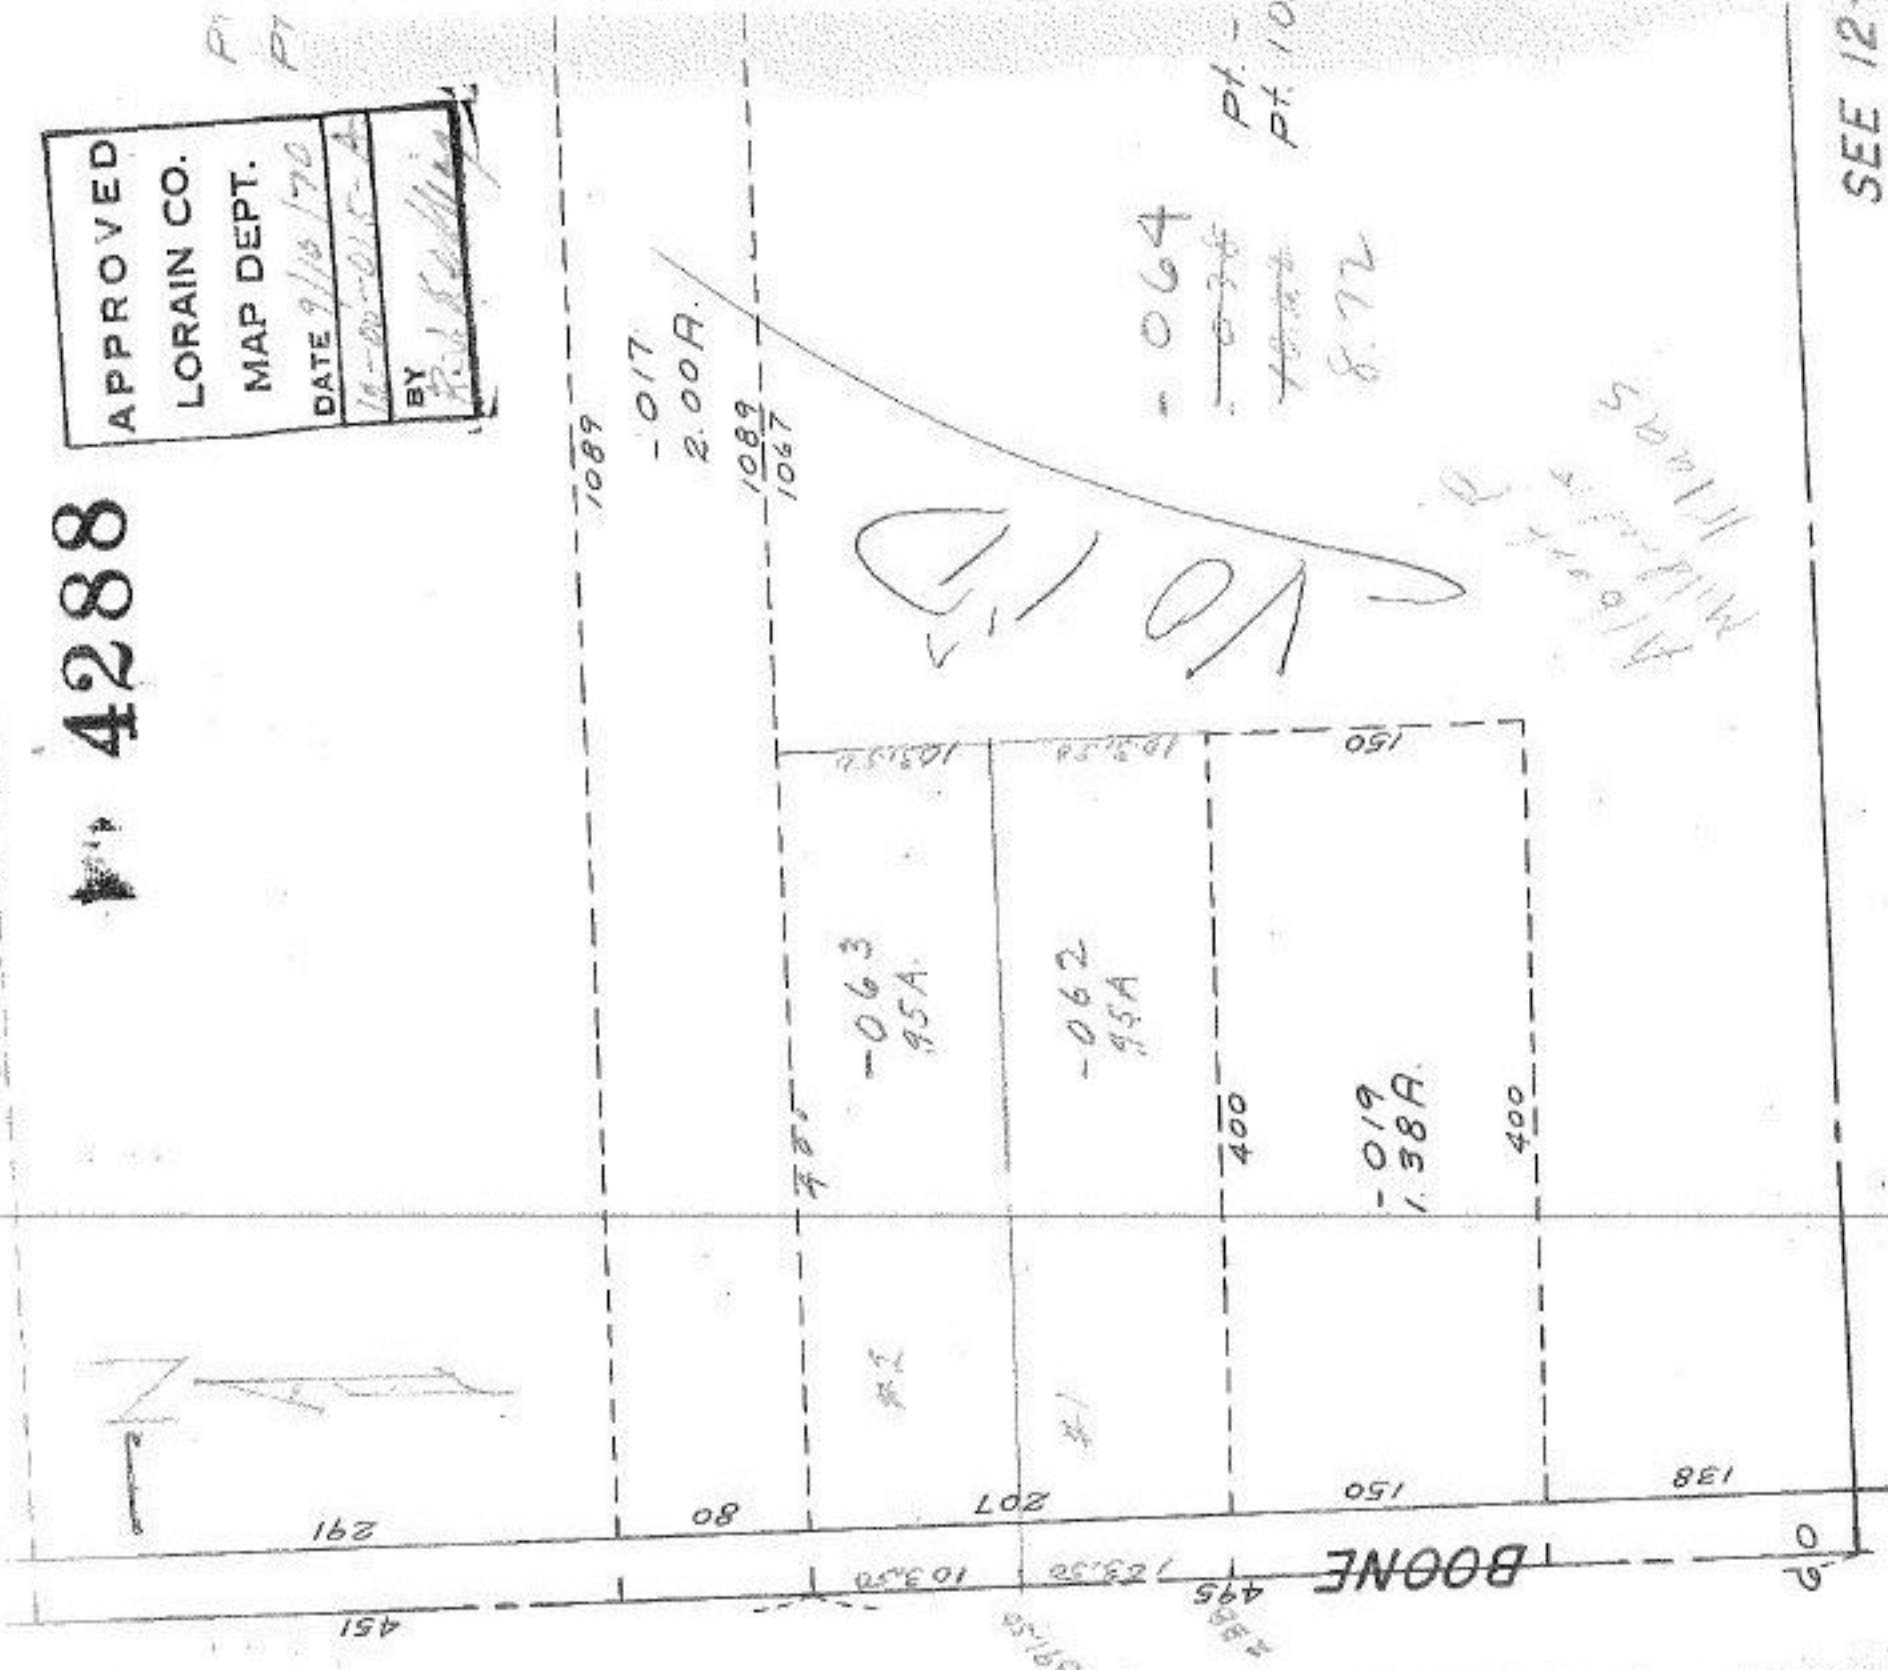

SEE 12.

COLUMBIA TWP.

SCALE: 1" = 100'