



NOV 13 1970

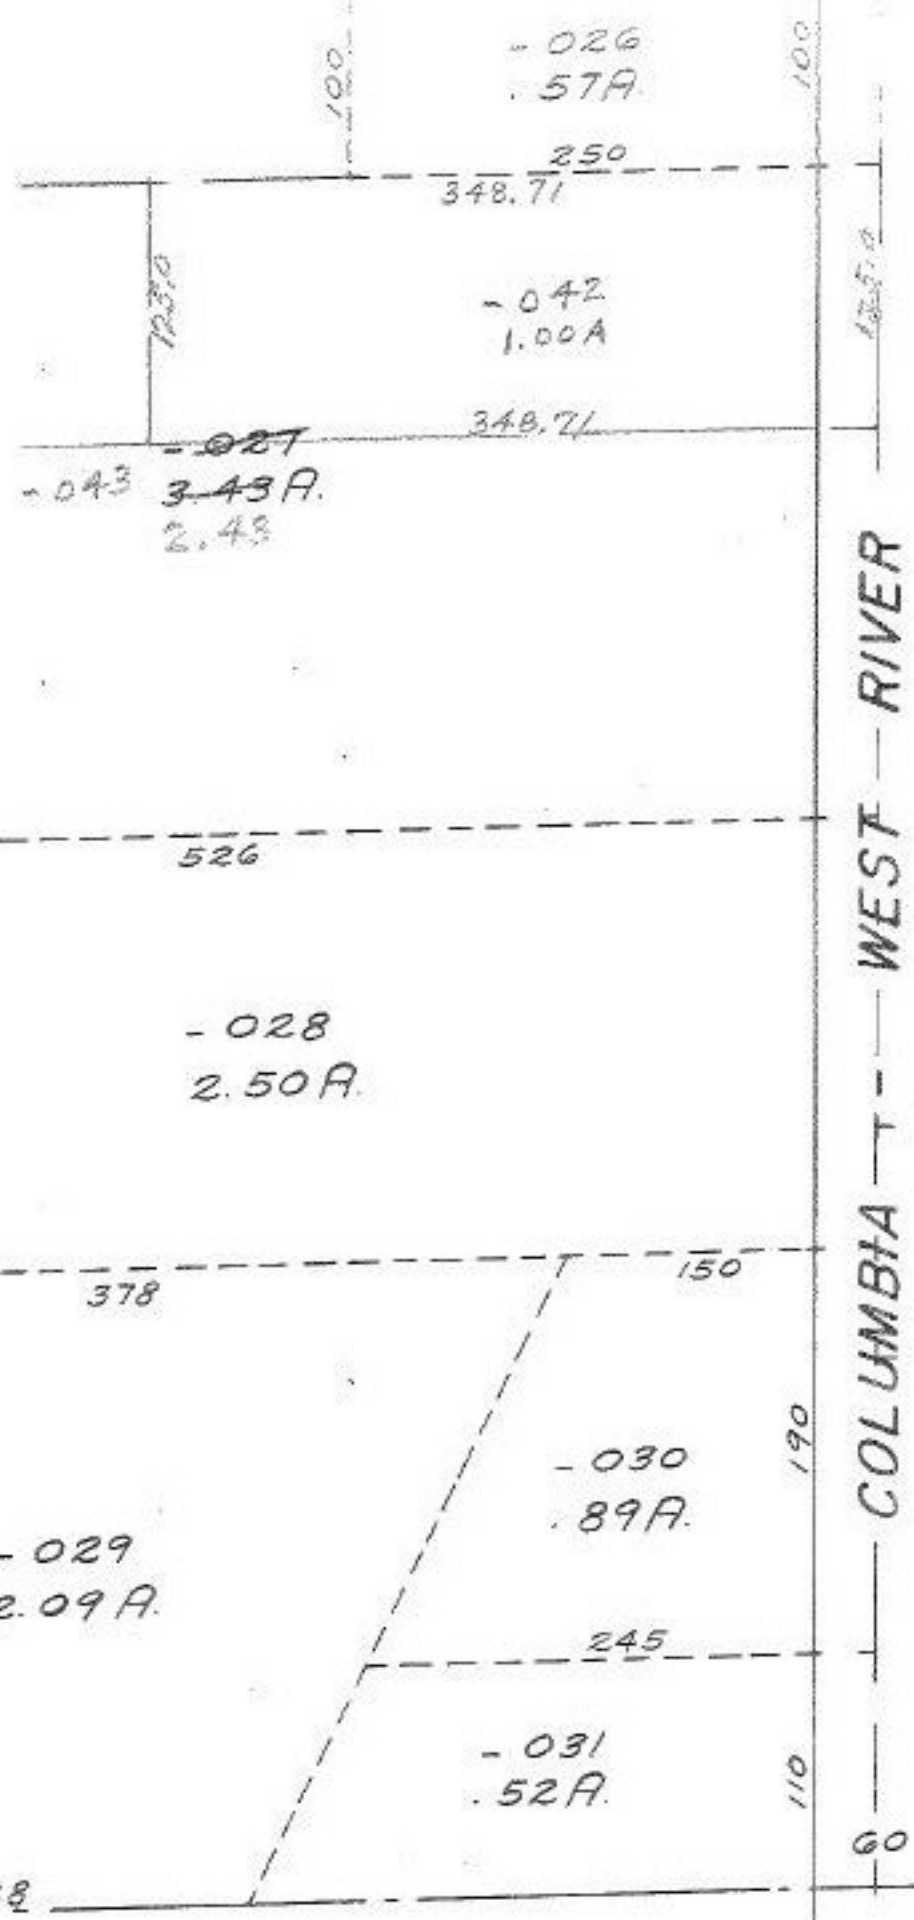

S. S. 7-28-56

429
 APPROVED
 LORAIN CO.
 MAP DEPT.
 DATE 9/11/70
 12-00-055B
 BY
 R. J. Keeling

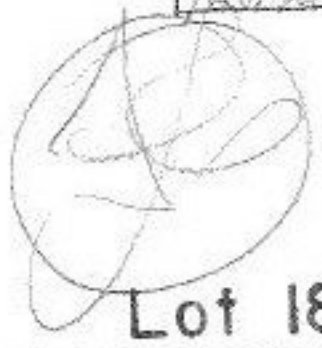

Lot 18

SEE 12-F