

4293

$$\begin{array}{r} 546.17 \\ 500.17 \\ \hline 46.00 \end{array}$$

$$\begin{array}{r} 375 \\ 25.17 \\ \hline 599.17 \end{array}$$




$$\begin{array}{r} 470 \\ 110 \\ \hline 580 \end{array}$$

4293

NOV 13 ENTD
 APPROVED
 LORAIN CO.
 MAP DEPT.
 DATE 9/11/70
 12-H
 BY
 K. J. Kelling

BOONE

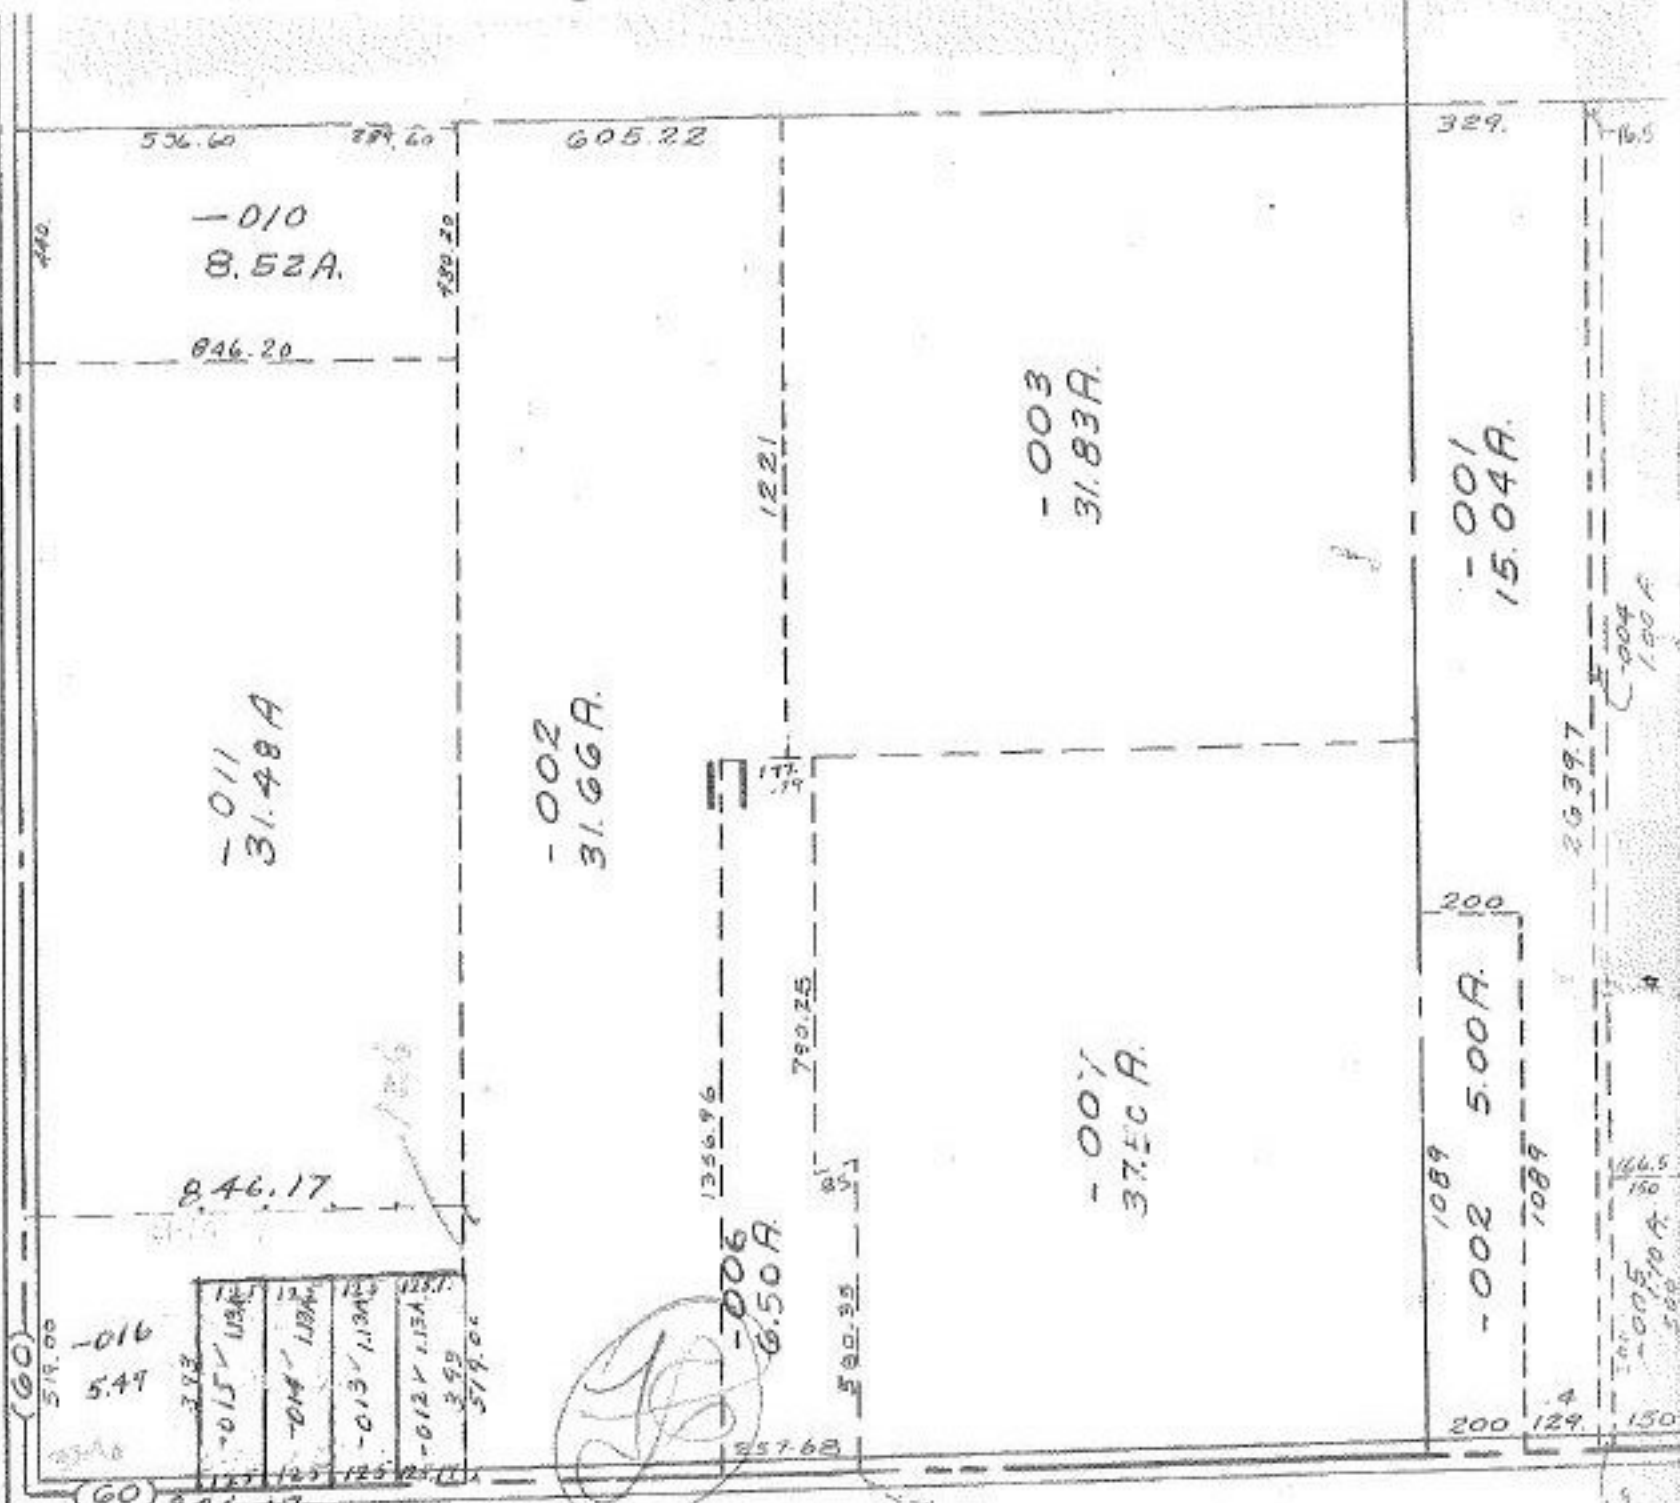

BOSTON

COLUMBIA TWP.

SCALE: 1" = 400'