


#4311

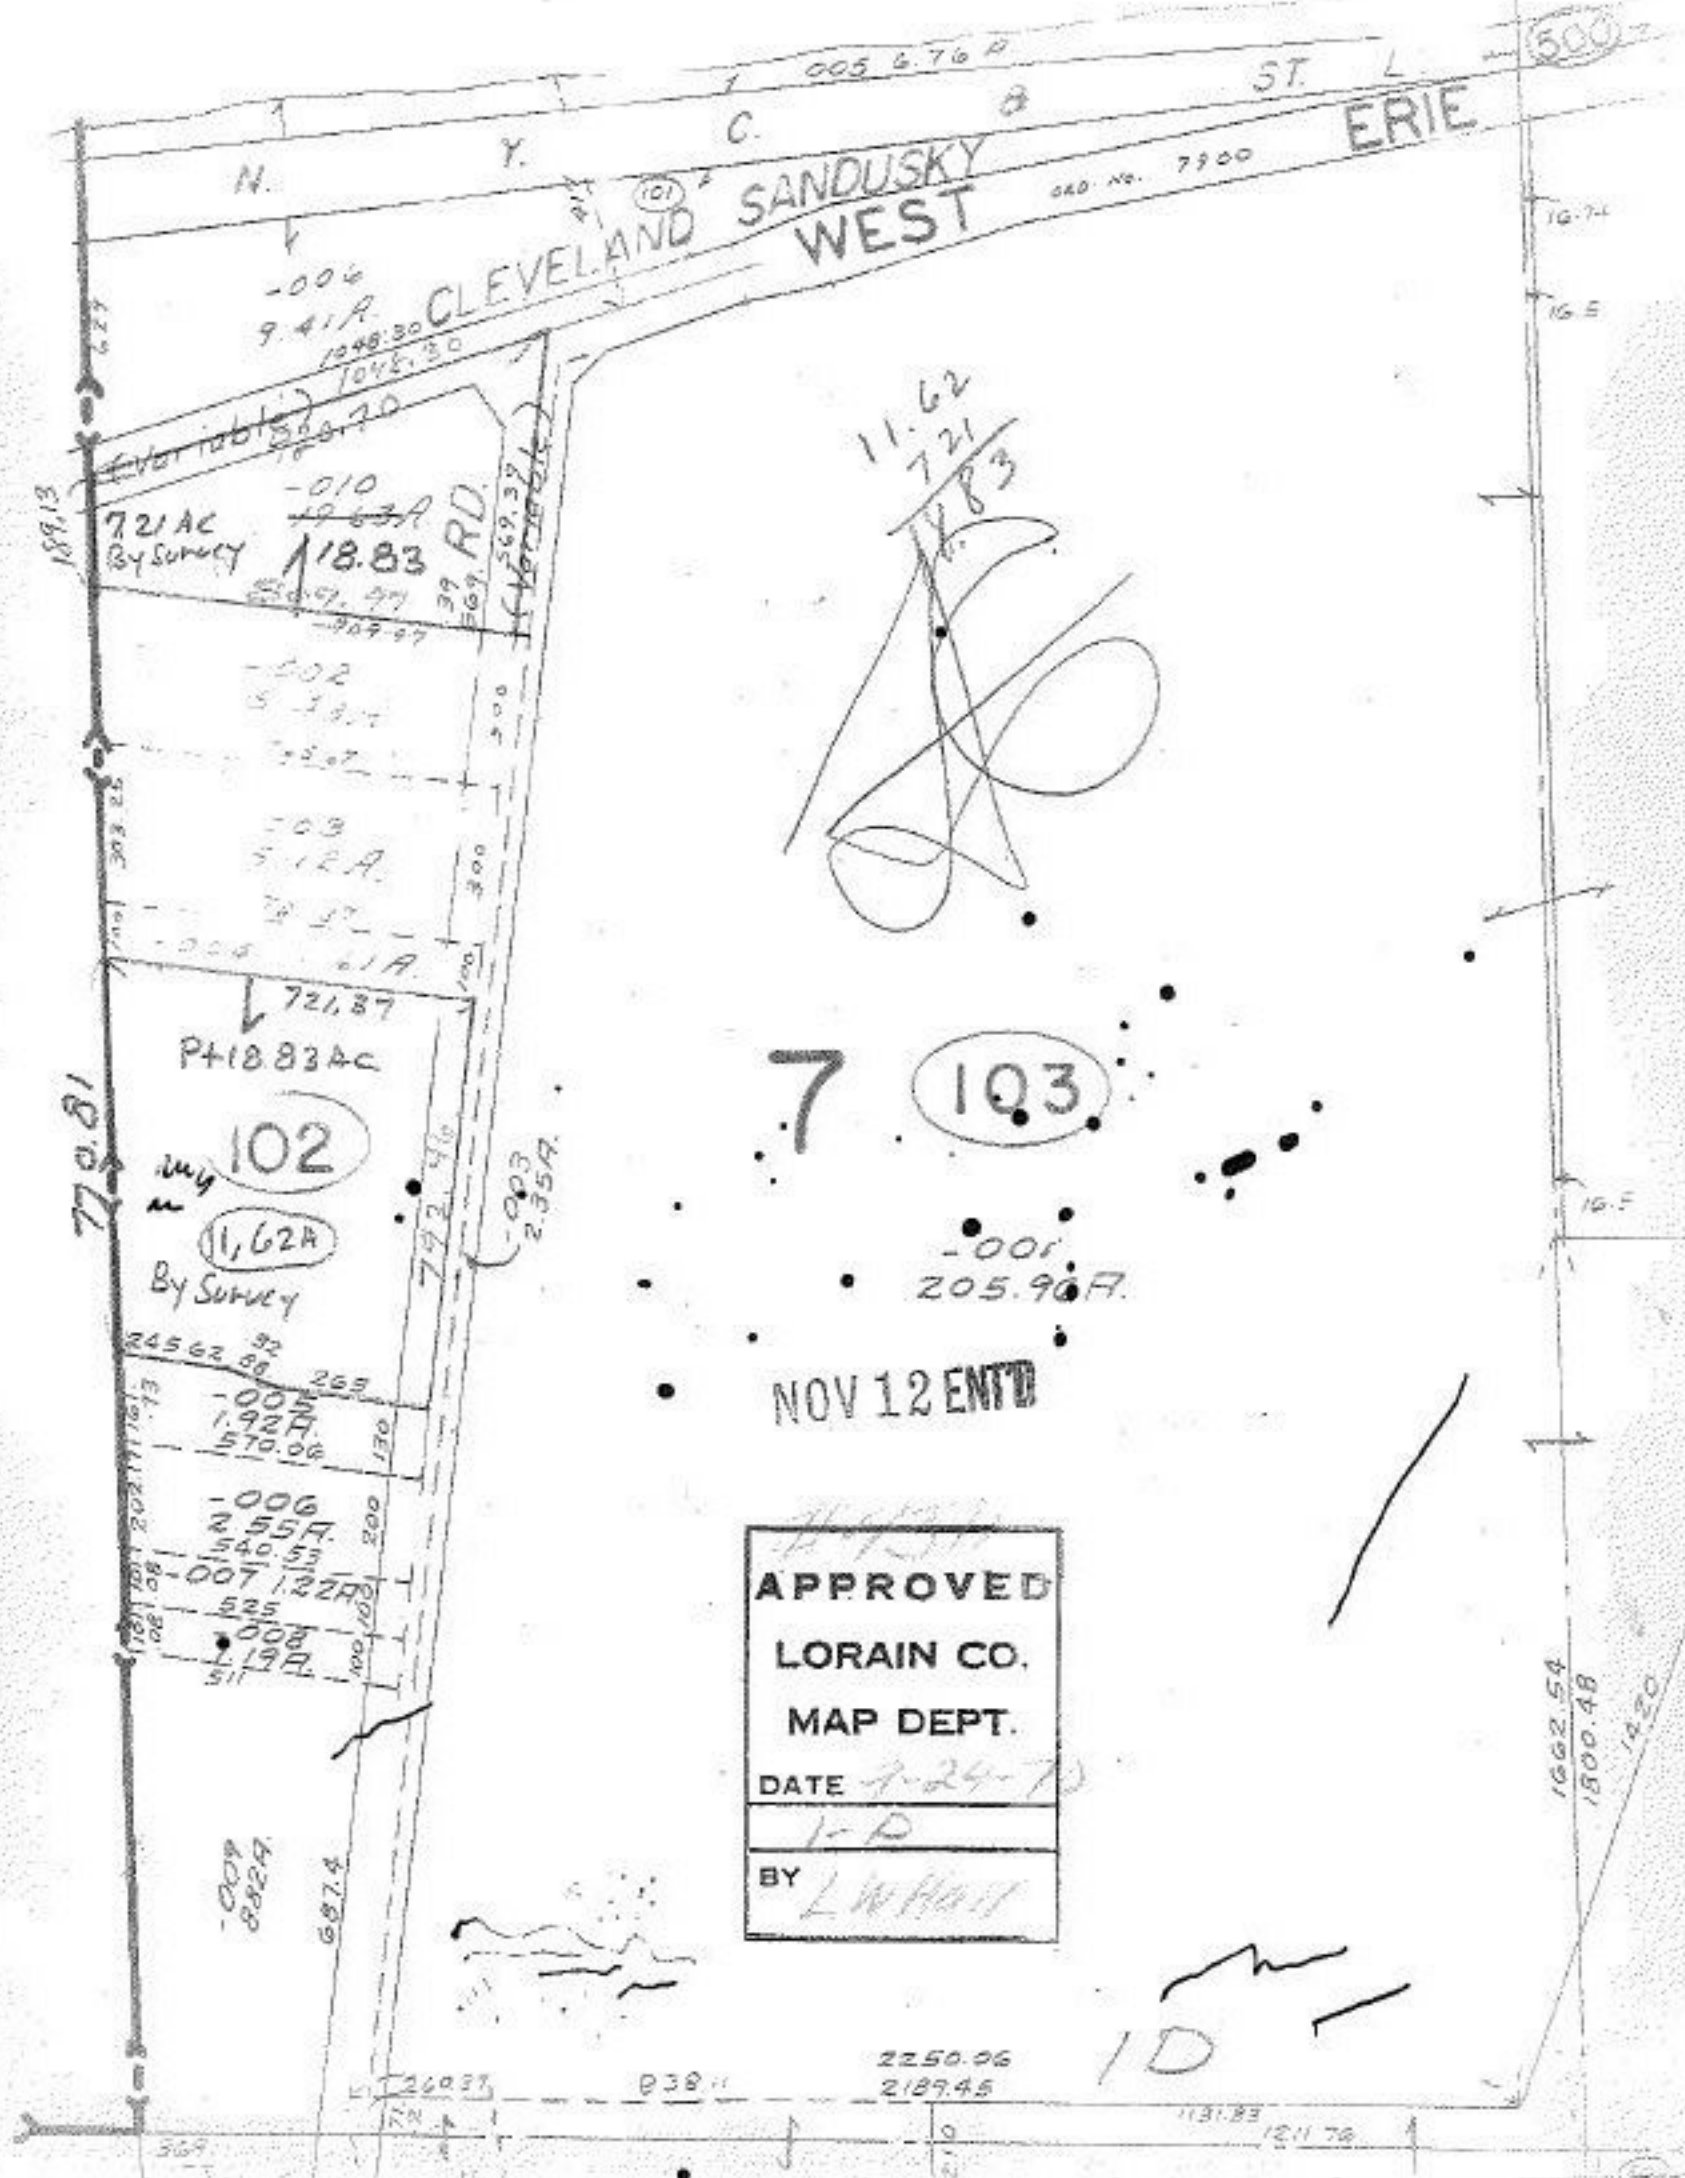

7 103

NOV 12 ENT'D

APPROVED  
 LORAIN CO.  
 MAP DEPT.  
 DATE 4-24-73  
 BY L.W. HART

ID