


4312

SEE 3-00-100-A

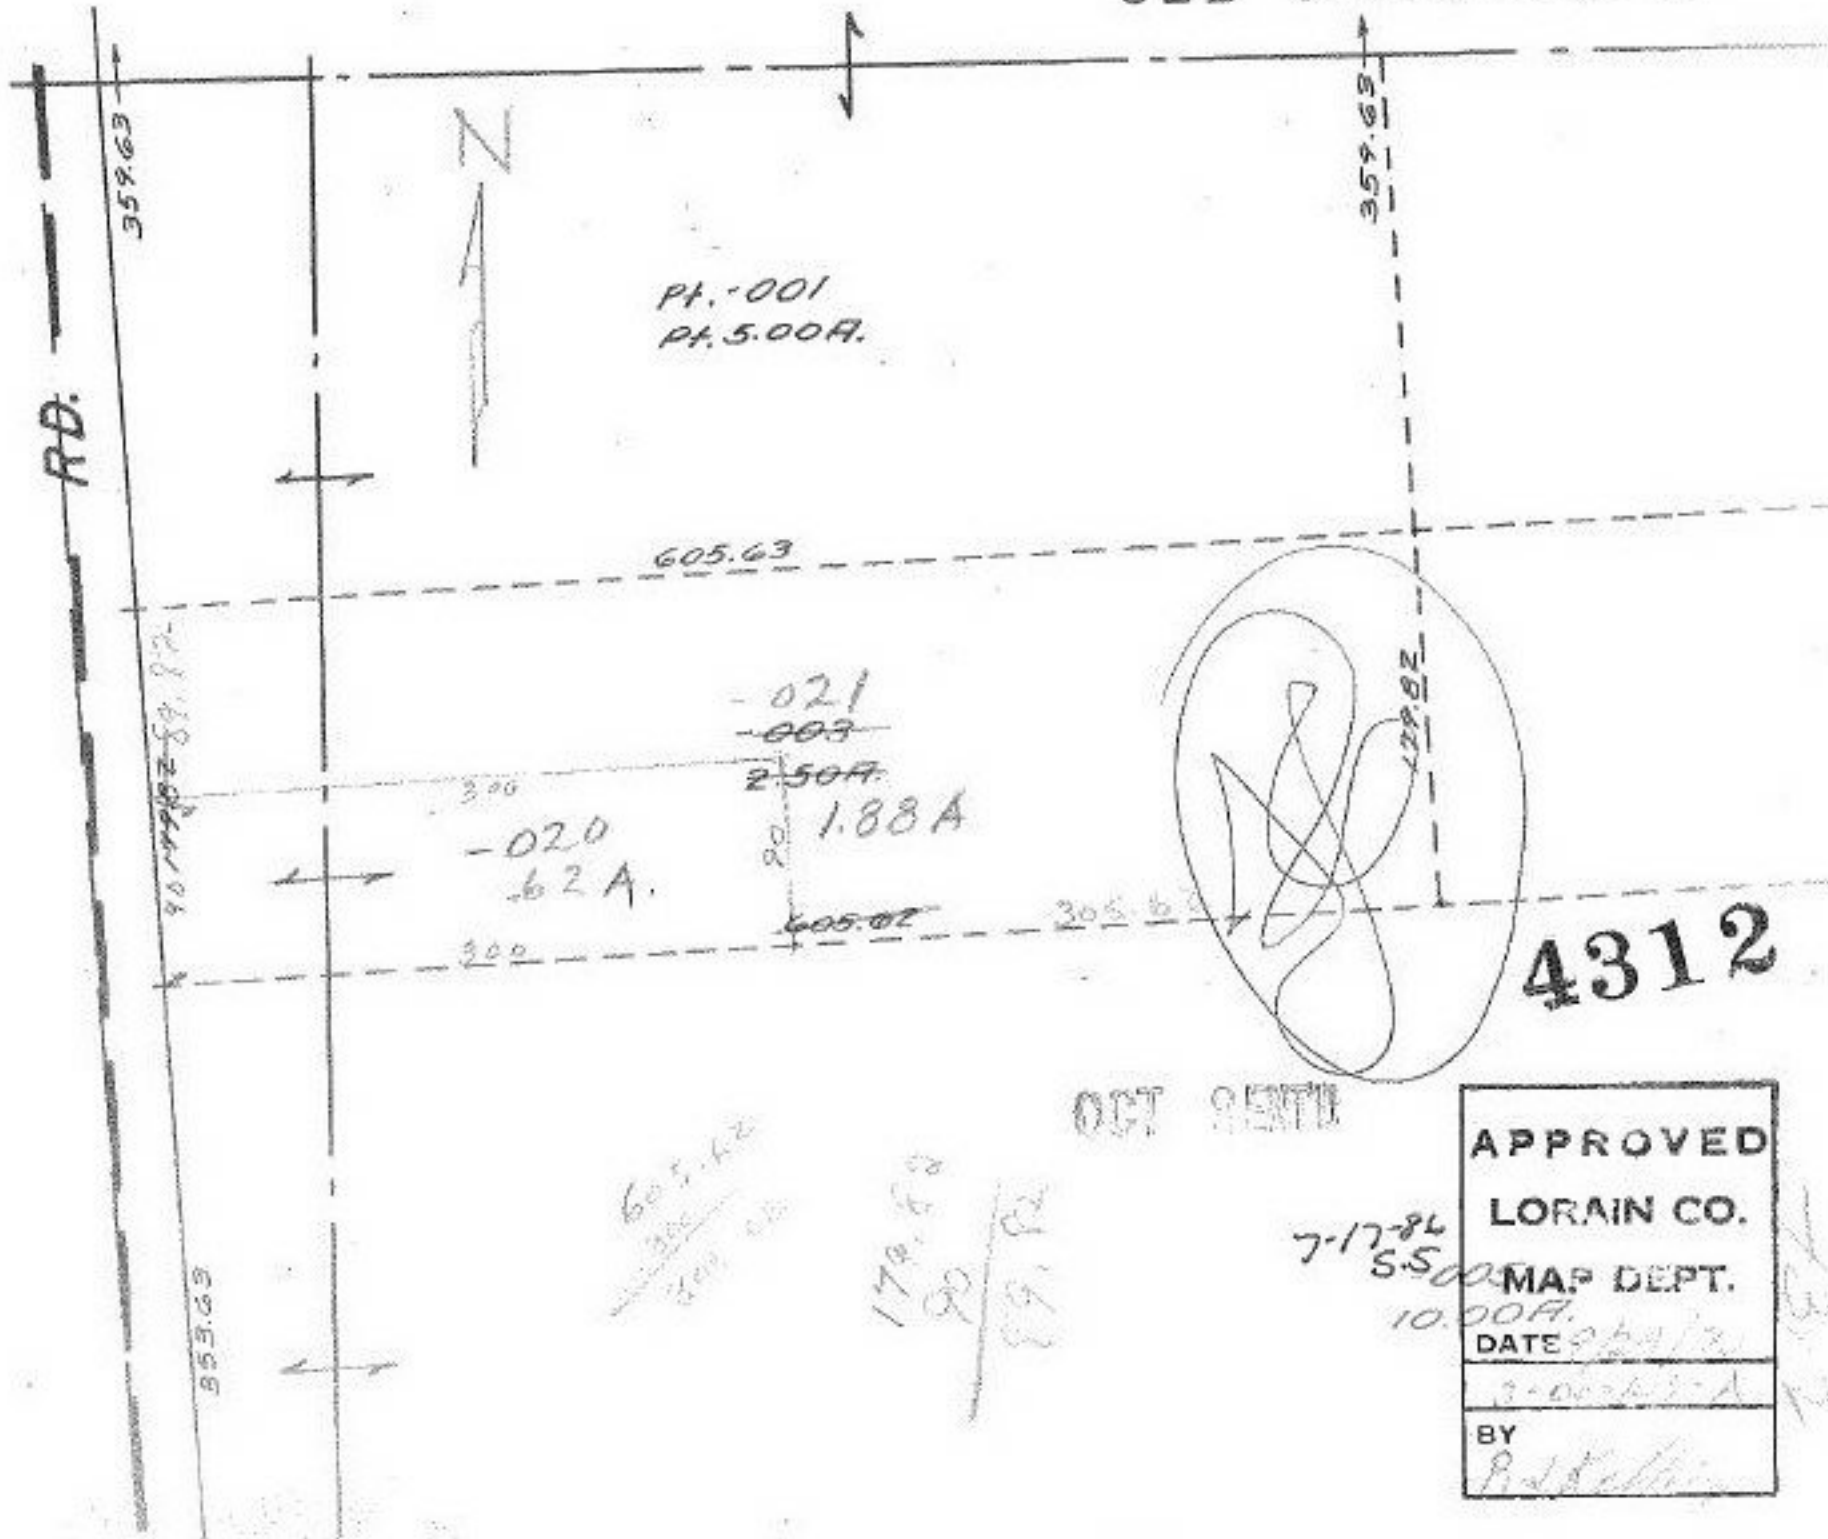

RD.

N

Pt. 001
Pt. 5.00A.

605.63


-021
-003

2.50A.

1.88A

-020
-62A.

605.02

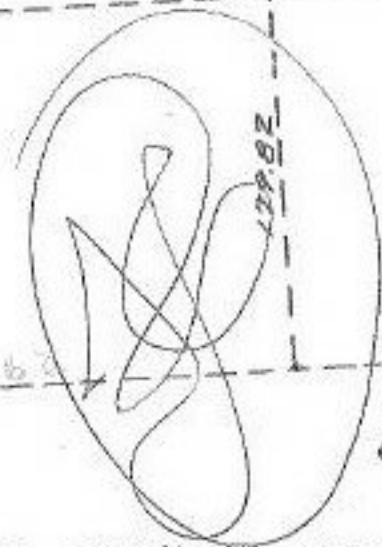

4312

OCT 2 1986

APPROVED
LORAIN CO.
MAP DEPT.
DATE 7-17-86
3-00-100-A
BY [Signature]

7-17-86
S.S.
10.00A.

605.42
300
300

179.82
20
89.82

353.63

359.63

359.63

90.9982 89.82

38.47
109.82