

C

-001
120.00 A.


T

2



OCT 9 1970

4320
 APPROVED
 LORAIN CO.
 MAP DEPT.
 DATE 9-29-70
 1913 & 19-04-001B
 BY LWHall

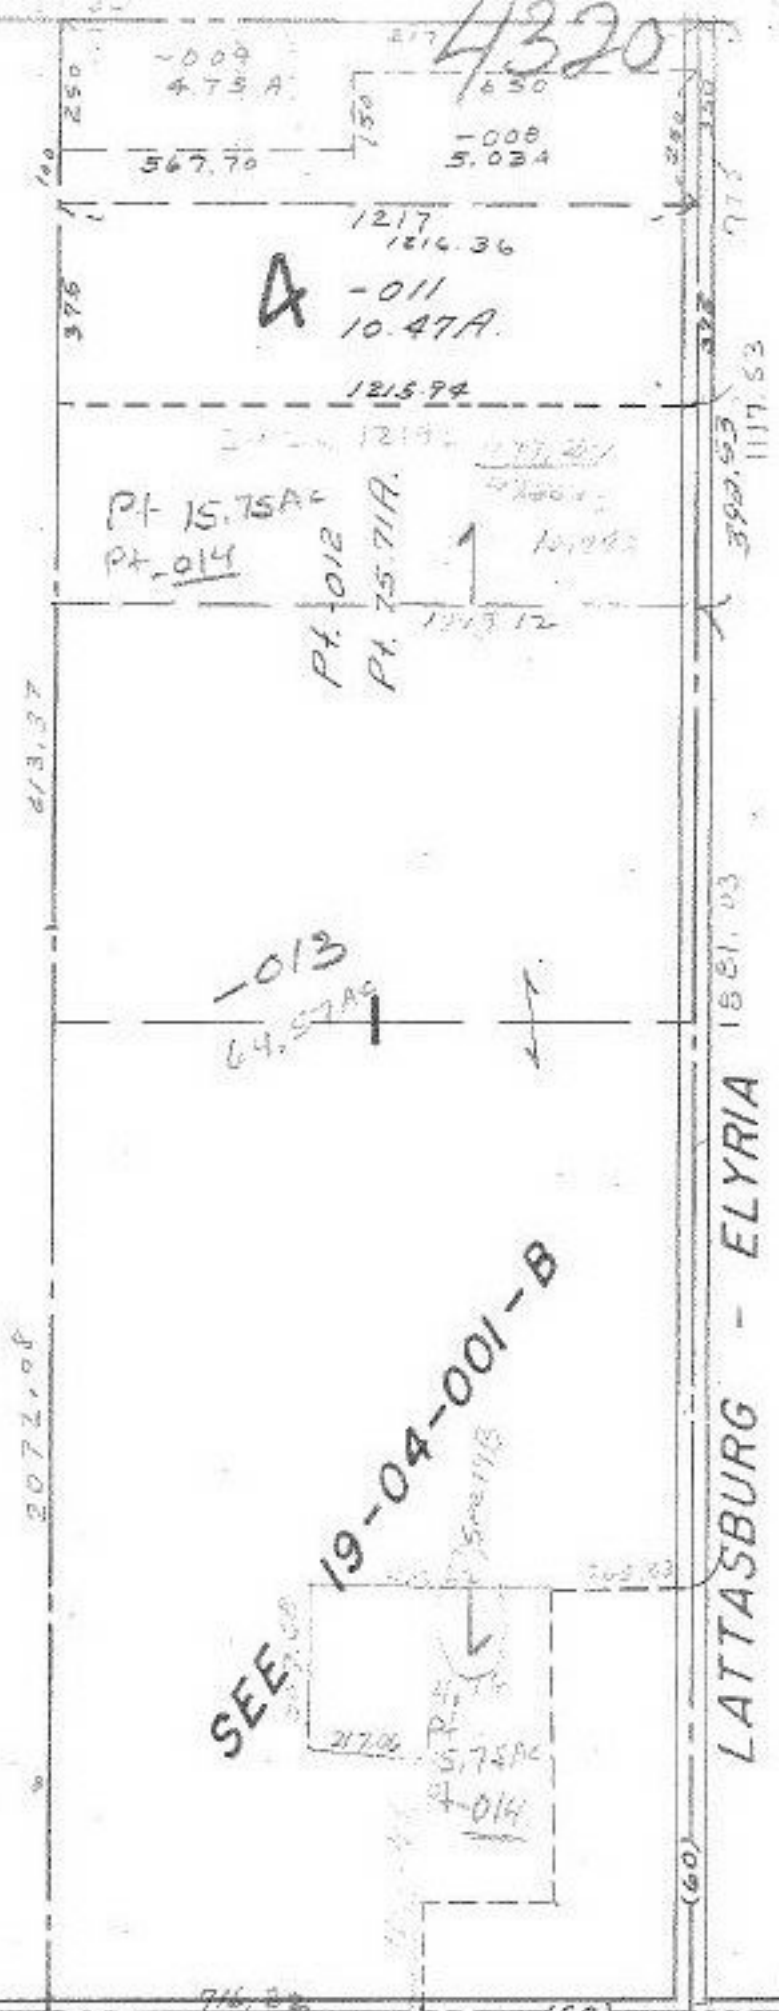

1117.53
 725
 392.53

TRACT 4 LOTS 1, 2, ELY. PT. 3
 " 5 " 9 THRU 12
 " " 100 " 112

