


2.13
 1.57
 2.23
 1.57



APPROVED
 LORAIN CO.
 MAP DEPT.
 DATE 10-1-70
 BY [Signature]

OCT 8 ENTD
 4321
 4322

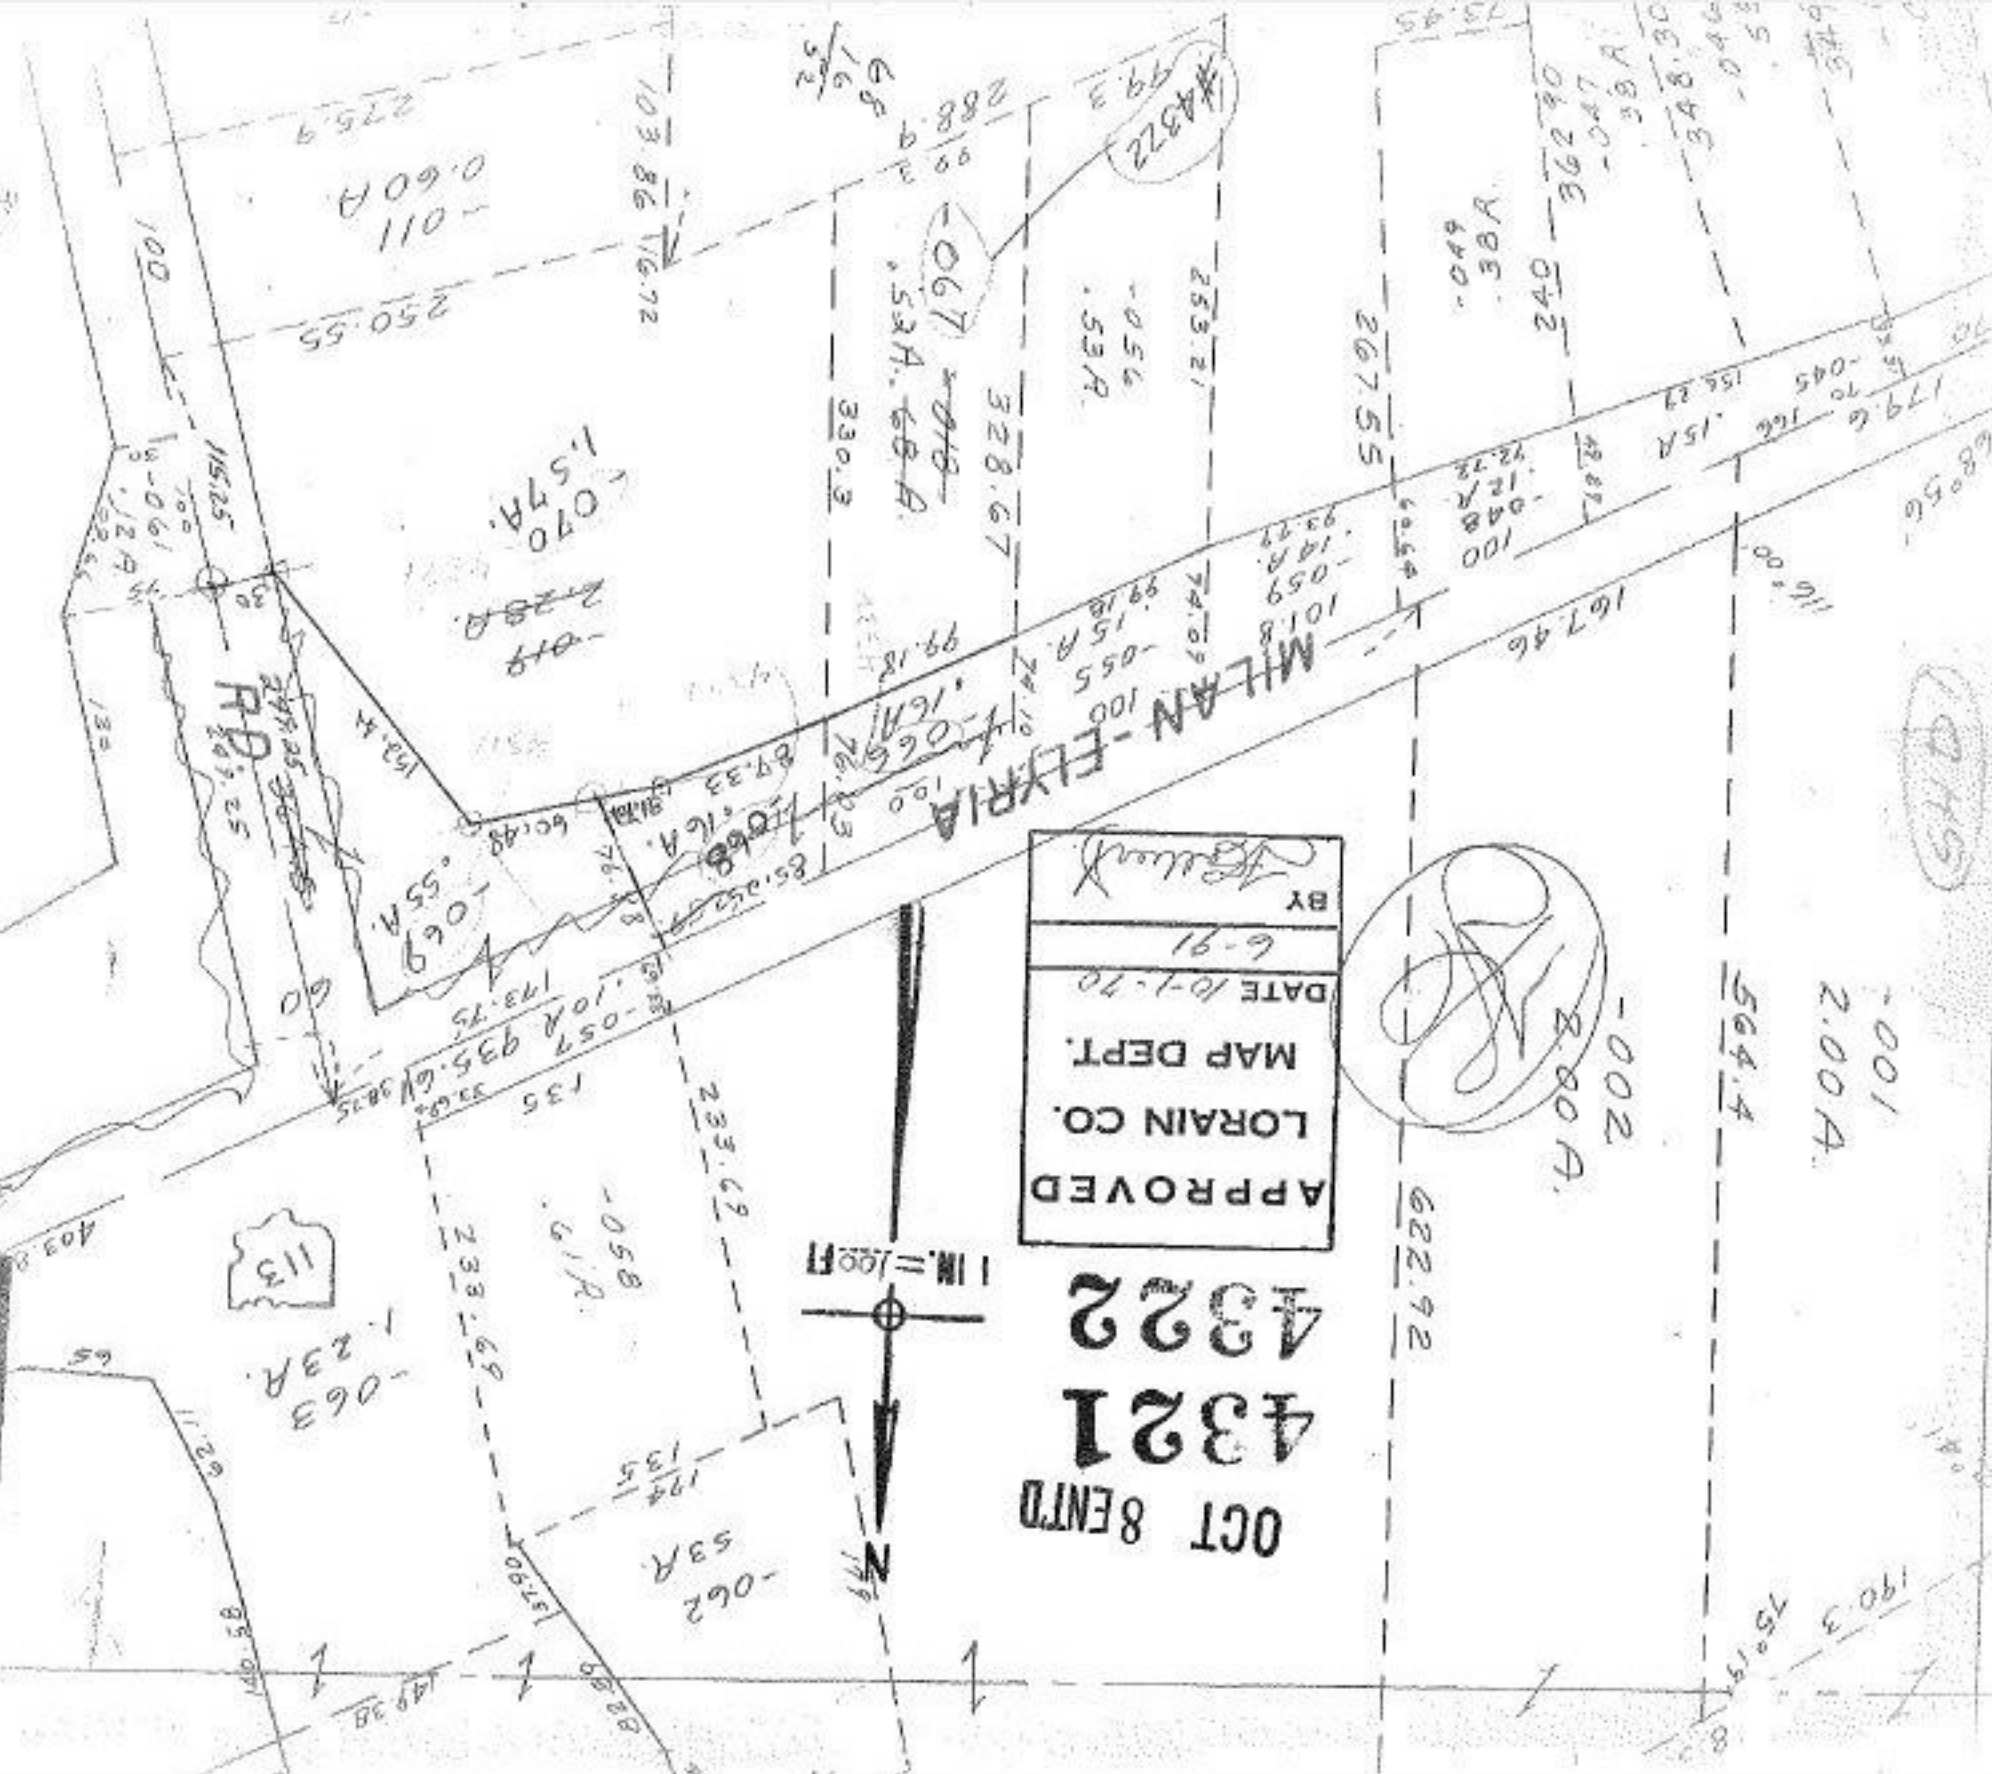

049

-001
 2.00A

564.4

-002

2.00A

622.92

190.3
 75°19'0"

68°56'

116°08'

167.46

100

12.22

154.23

242

38A

06790

58

101.8

14A

93.72

74.09

253.21

4322

056

53A

328.67

067

53A

68A

288.90

1/6

68

330.3

99.18

16A

76.03

85.25

108

108

103.86

176.72

1.070

1.57A

2.28A

2.28A

0.60A

250.55

100

15.25

100

100

