


4323

4323

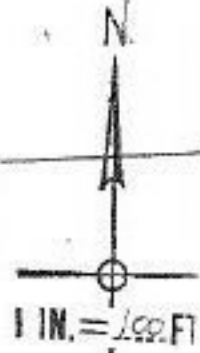



APPROVED  
 LORAIN CO.  
 MAP DEPT.  
 DATE 10-1-70  
 6-91 d 6-73  
 BY *[Signature]*

*Change Acreage  
 & Revisited No. on  
 Page 6-73*

*50.85  
 51.21  
 2.32  
 48.74  
 1.15  
 47.59*



OCT 7 ENT'D *pt. -010*  
*pt. 47.59 A.*

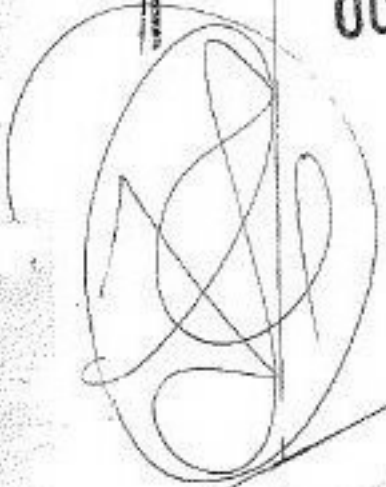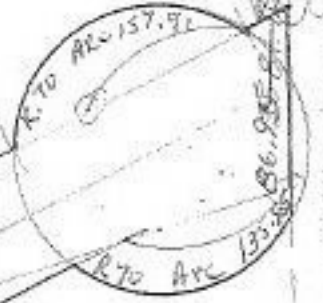

*559.99  
 -009  
 559.81* 19

*PL 001  
 PL 50.85 A*

*49A*  
*346.01*

*178.77*

*518.77*

*299.94*

*-008  
 2.32 A.*

*RD*

*161.42*  
*57.10*  
*28.27*

*250  
 202.87  
 350*

*641.19*

*136.05*  
*134.24*

*ARC 494.08*  
*494.51*  
*R. 1112.92*



*-050  
 169 A.*

*528.13*

*SHD*