



4326

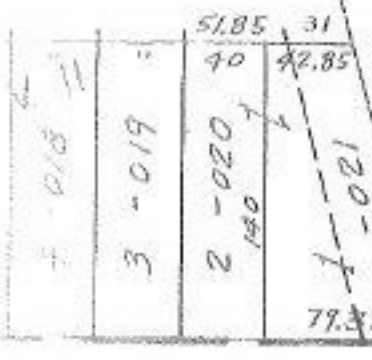

6-80

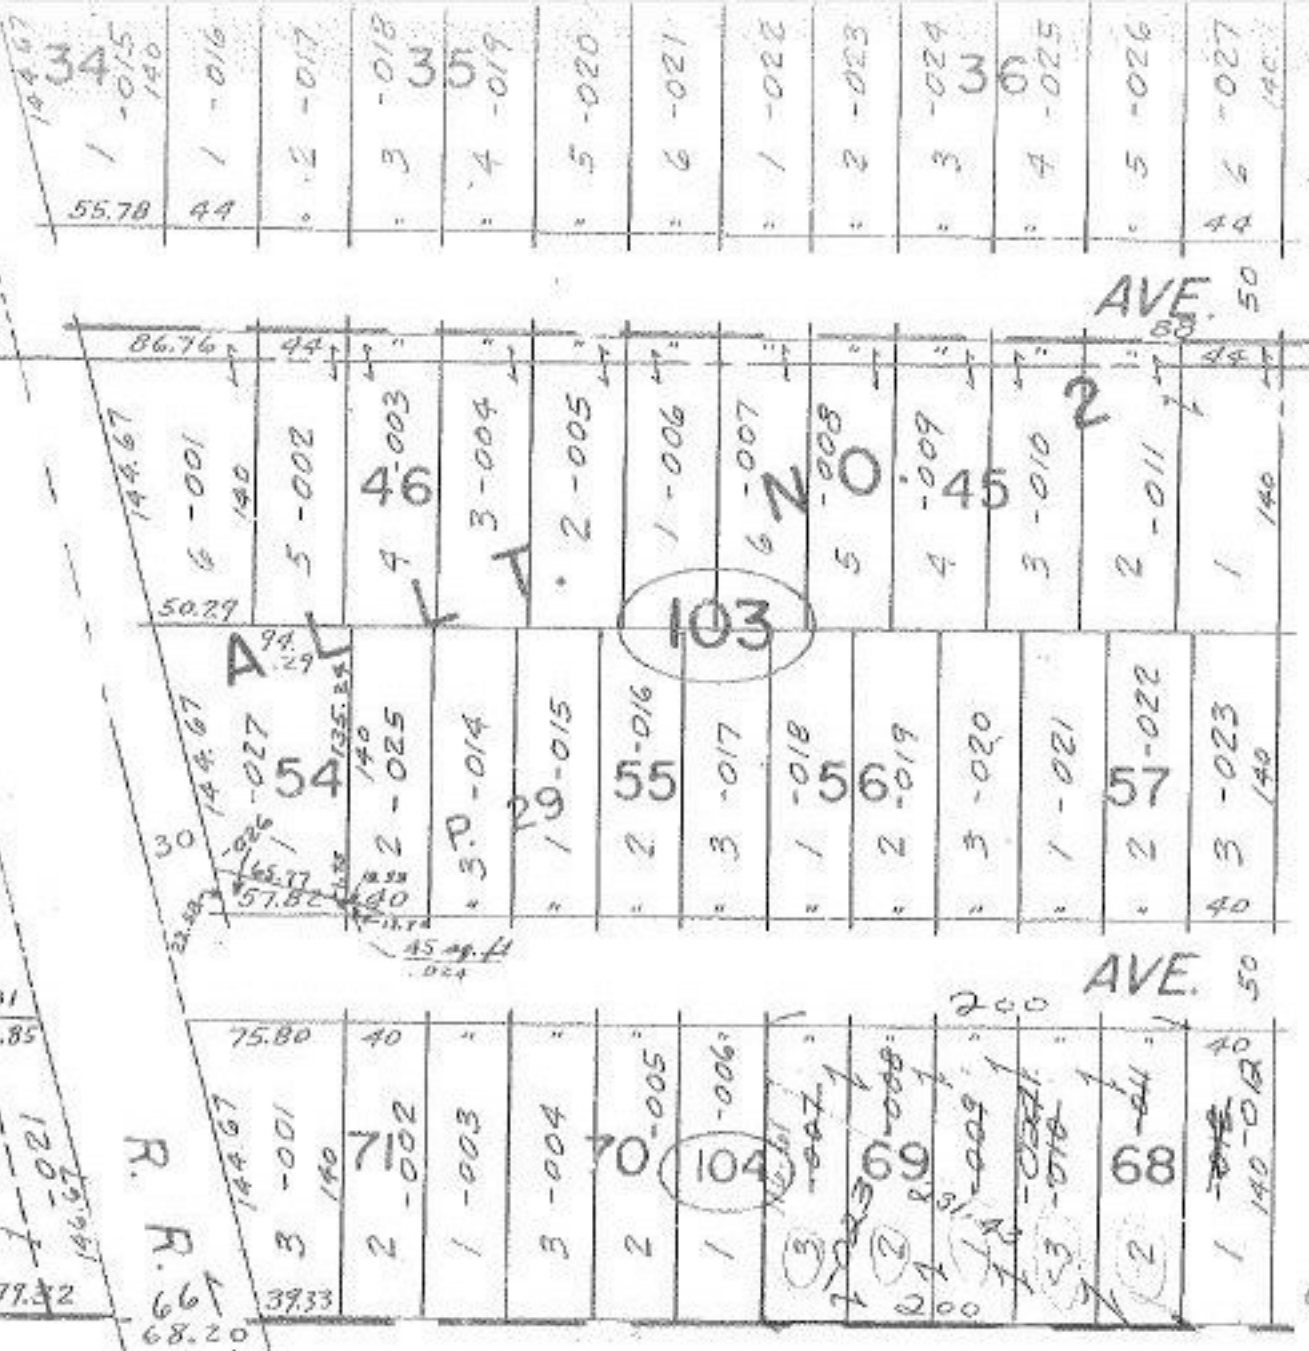

ADAMS

AVE. 50


AVE. 50



OCT 6ENTD

4326

APPROVED
LORAIN CO.
MAP DEPT.
DATE 10-1-70
6-62
BY <i>J. Bell</i>

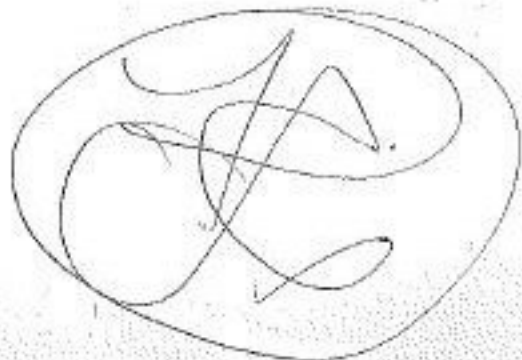

S.H.D.

116.61

WEST OF RIVER  
PT. LOTS 33, 34 & 27