


OCT 23 ENT'D

4336

4337


APPROVED
 LORAIN CO.
 MAP DEPT.
 DATE 10-1-70
 400.004-H
 BY *[Signature]*

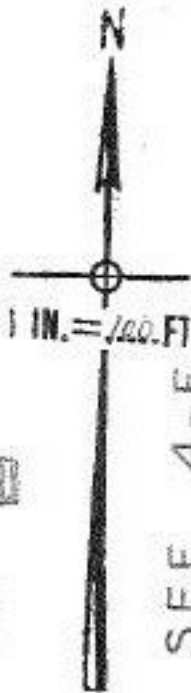

SEE 4-E

1562.06
 -102
 3.47A 3.58A
 1561.50
 -102
 3.45A 3.58A
 1560.99

7-17-86
[Signature]

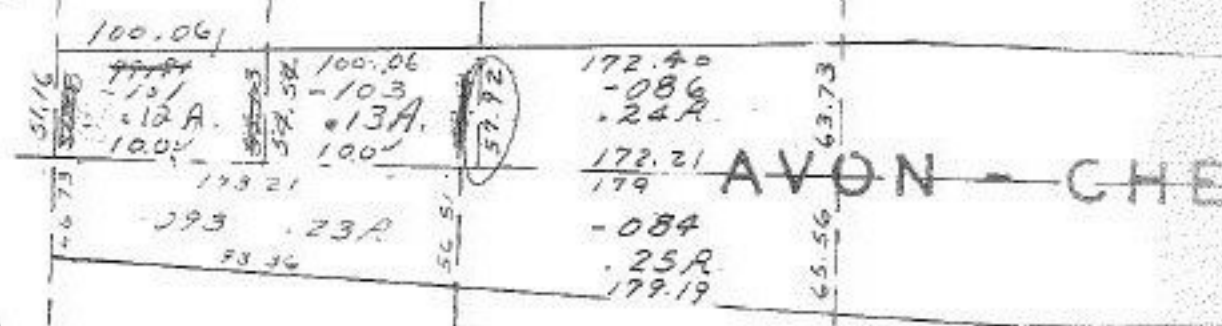

AVON - CHE

[Signature]