


171.50
 729.33

 42.17

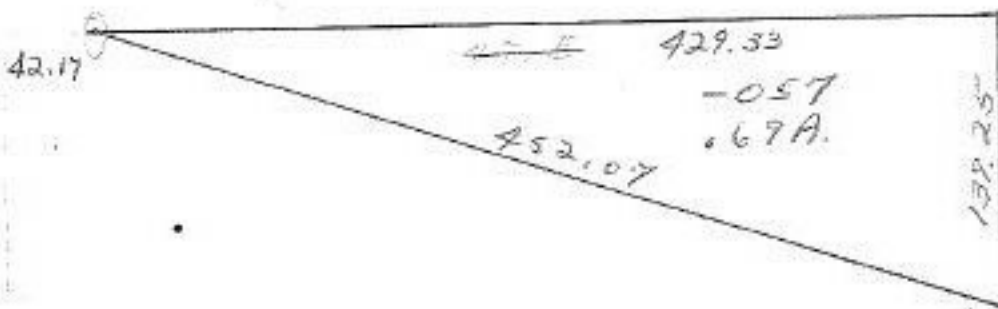


-058
 39.10A

~~37.56A~~

4338



APPROVED
 LORAIN CO.
 MAP DEPT.
 DATE 10-5-70
 #4-00-015 B & F
 BY *K. Kallert*

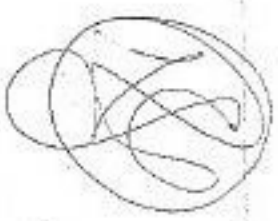

10-14-70

Transfer Sheet
 Filed

4-00-015-B

1810.55

37.56
 1.62

 36.87
 1949.40
 139.25

 1810.55