


503

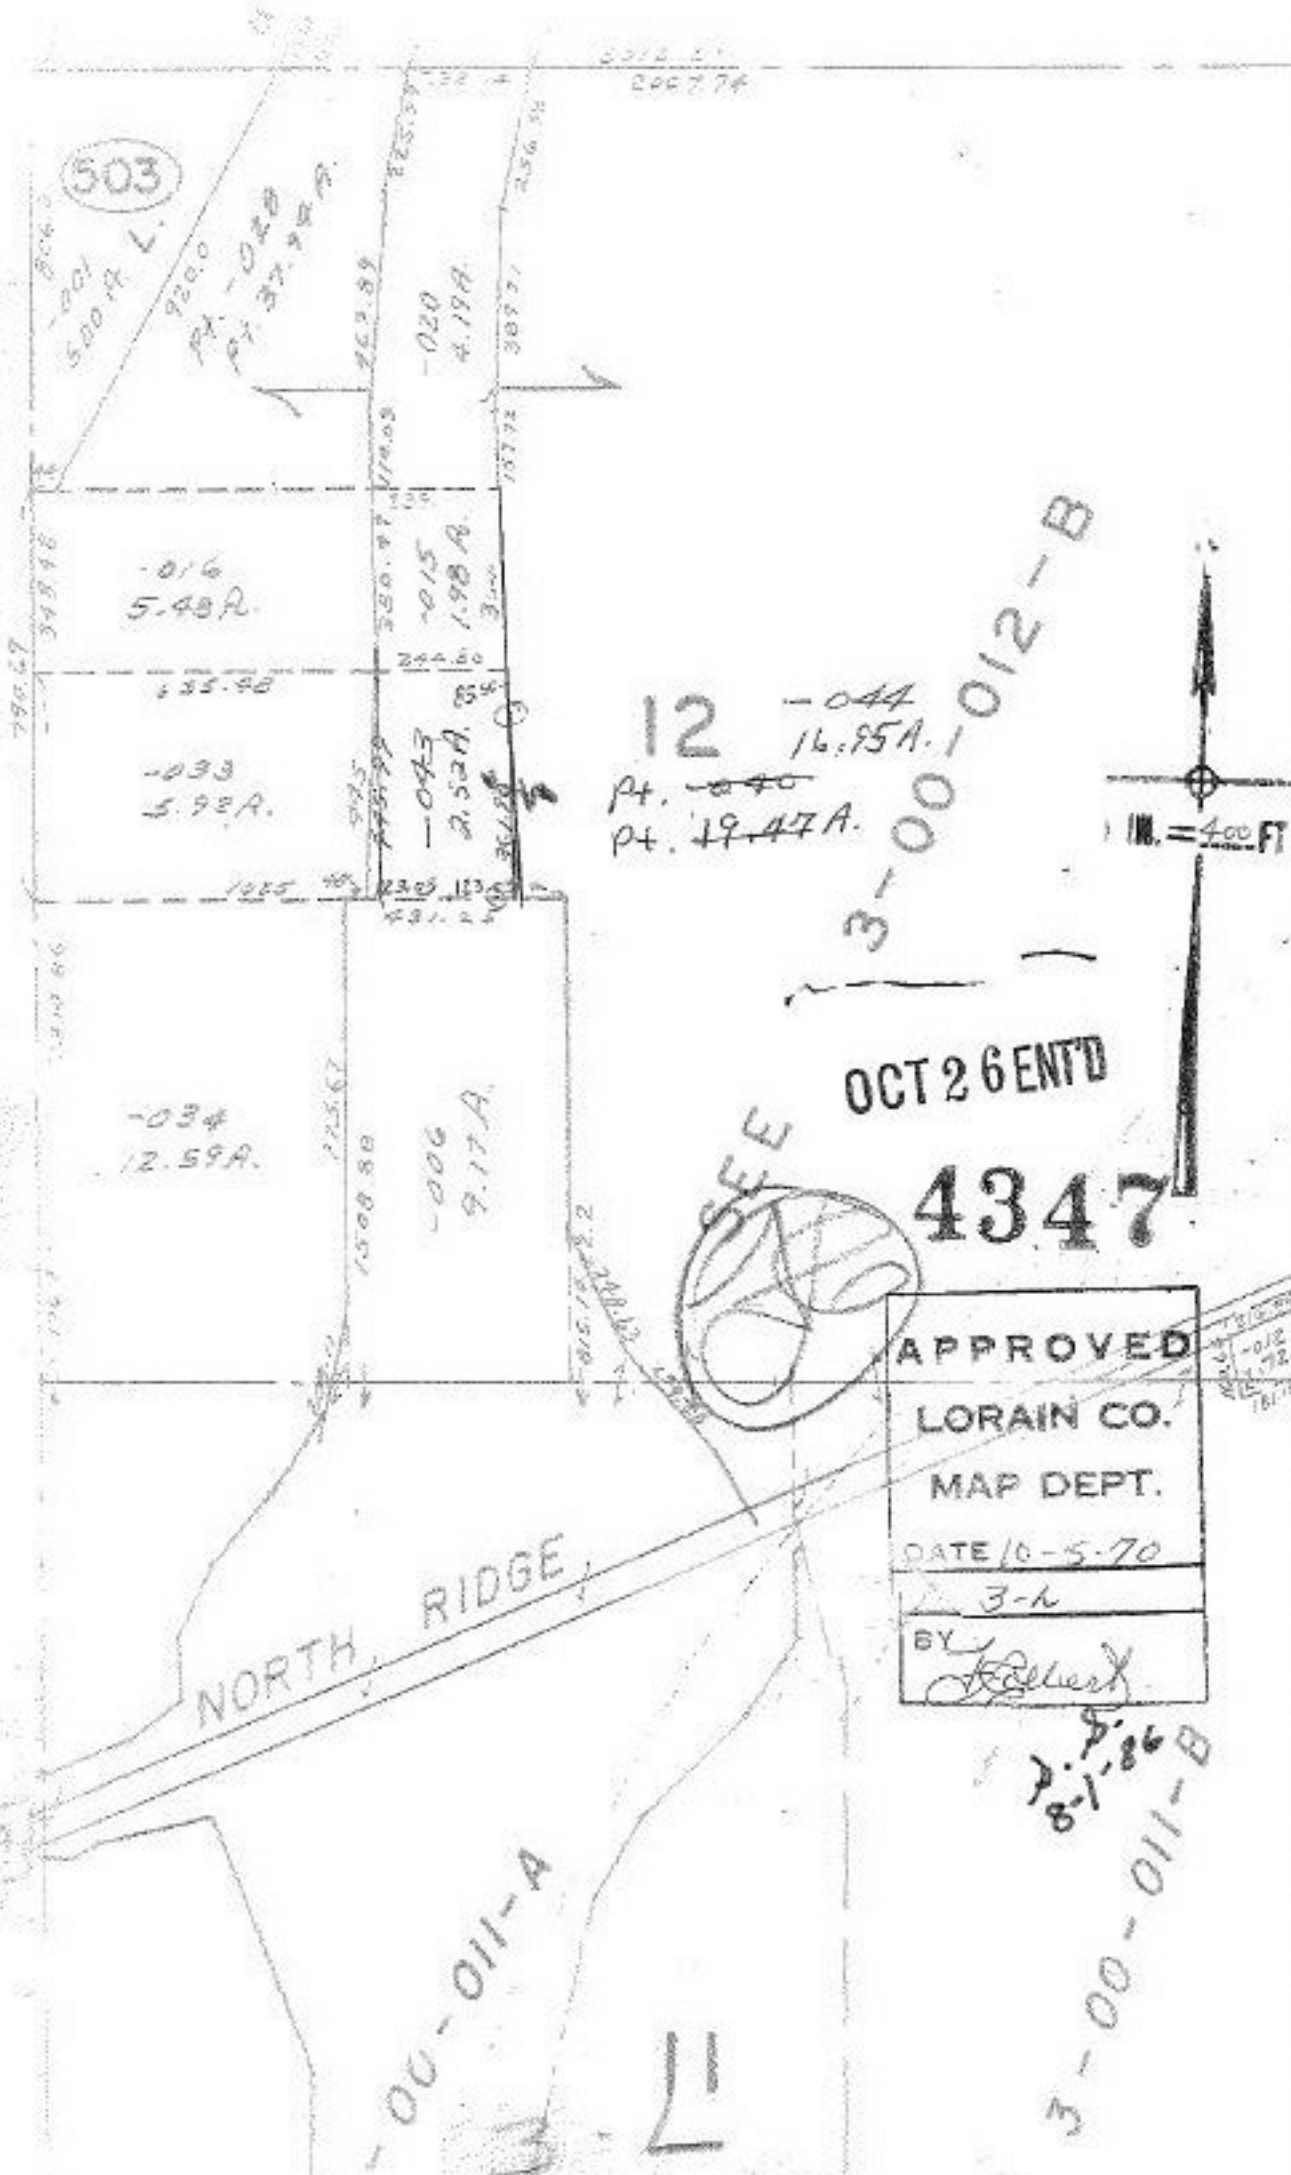

12 -044
 Pt. 19.47A
 16.85A.1

19.47
 2.52
 16.95

OCT 26 ENT'D

4347

APPROVED
 LORAIN CO.
 MAP DEPT.
 DATE 10-5-70
 J. Bellert
 BY

3-00-011-B
 781-86-B

SEE

SAD