


4354

NOCT 26 ENT'D

APPROVED  
 LORAIN CO.  
 MAP DEPT.  
 DATE 10-13-70  
 4-00-028-G  
 BY *[Signature]*

4353

1 IN. = 100 FT

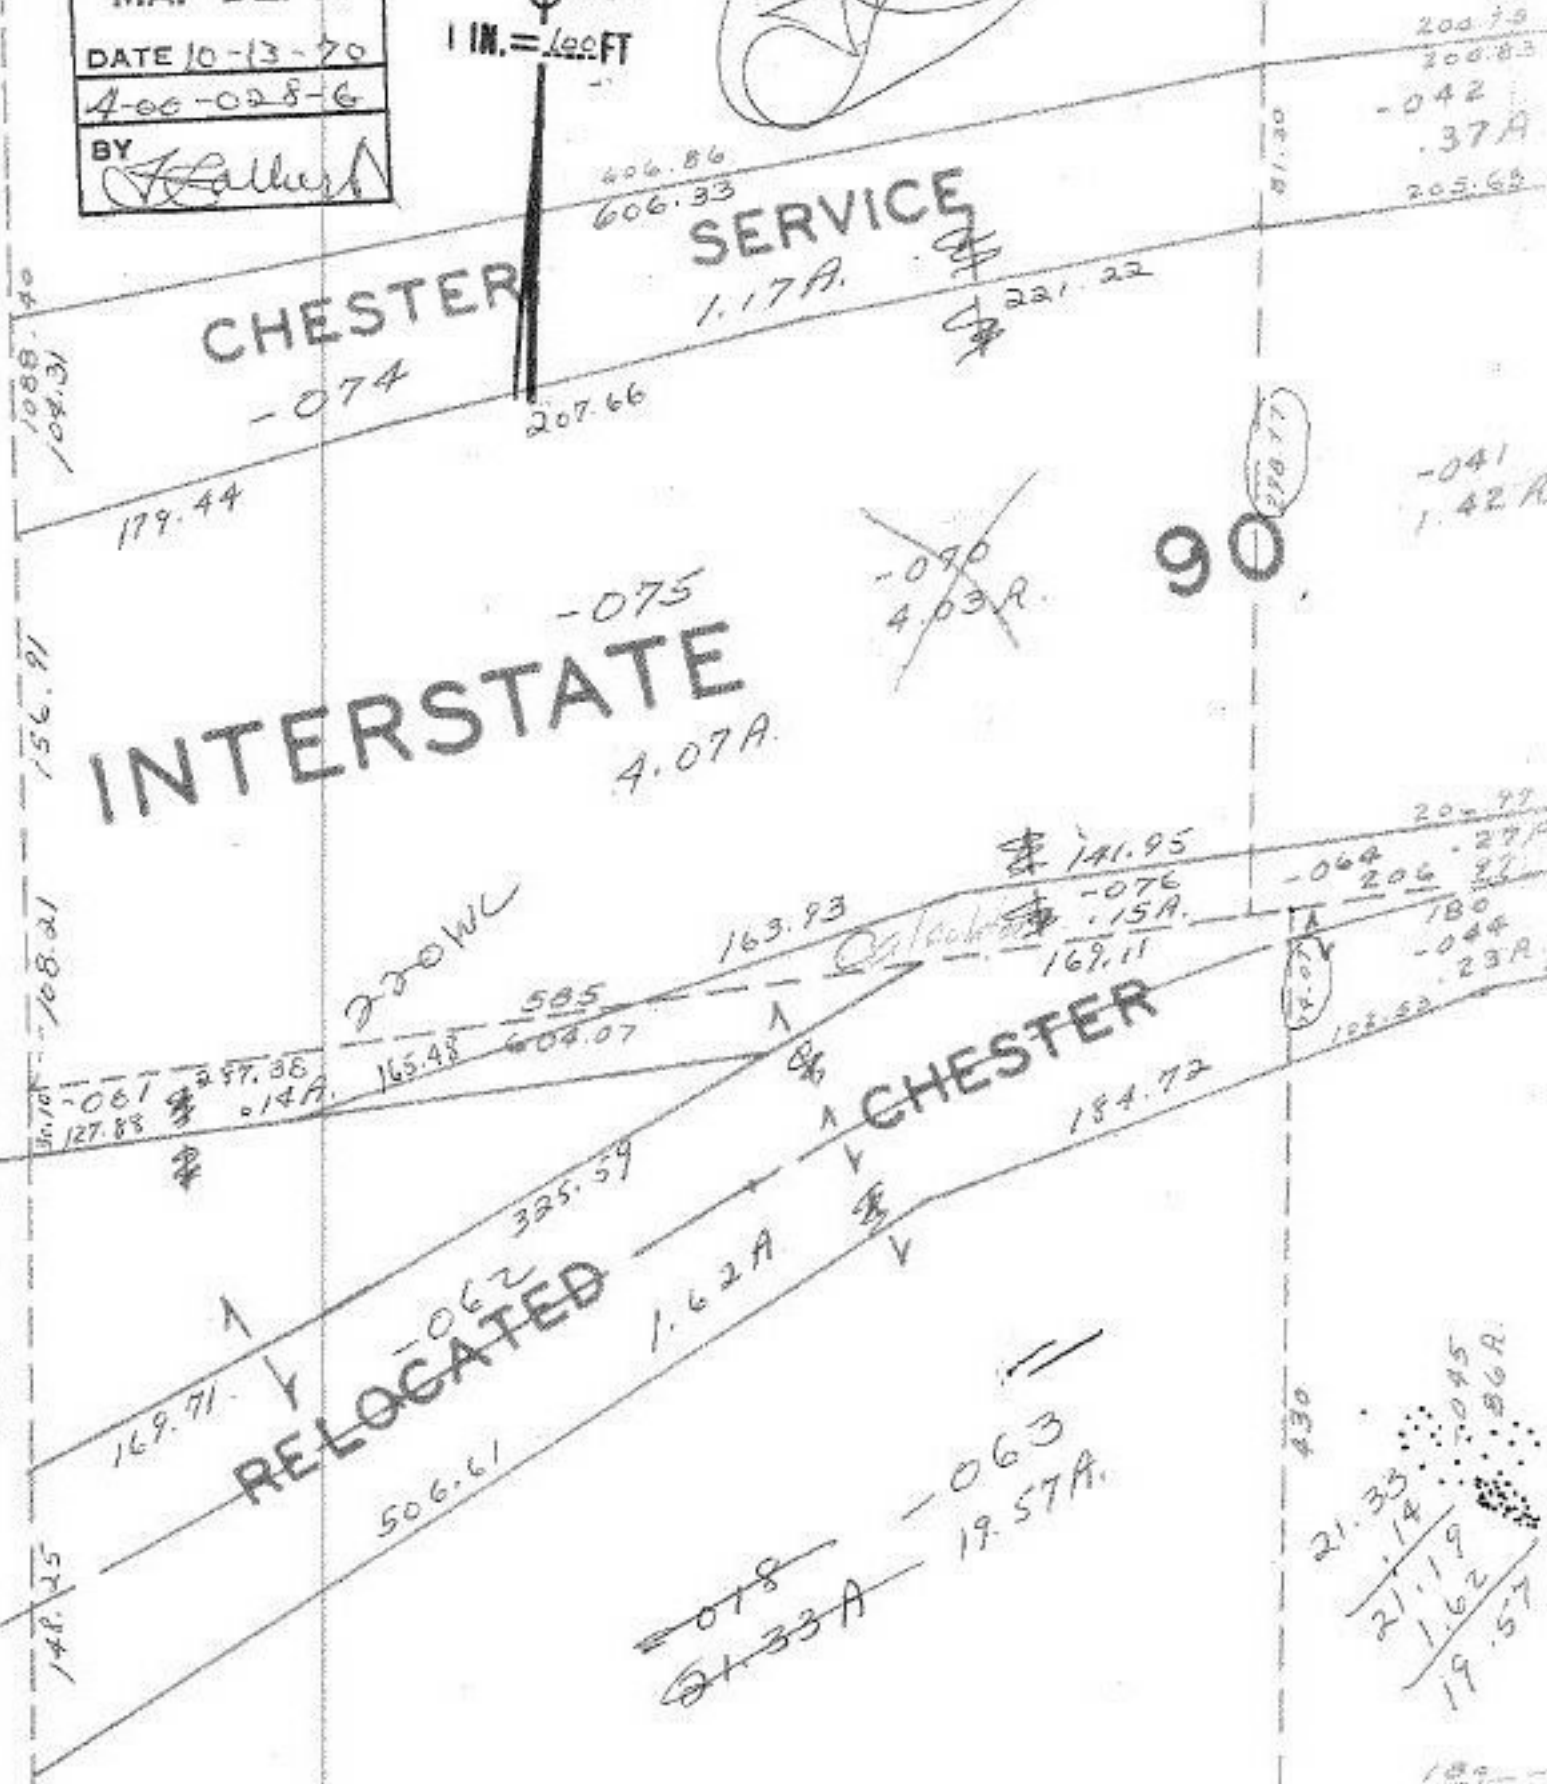

CHESTER -074

SERVICE 1.17A

INTERSTATE -075 4.07A

RELOCATED -062

CHESTER -076 1.5A

4-00-028-G

*State Registrar*