

301

4363

438.19


-070
7.35A.




OCT 30 1970

4363

APPROVED
LORAIN CO.
MAP DEPT.
DATE 10-15-70
10-60-013-B
BY *J. Ballant*

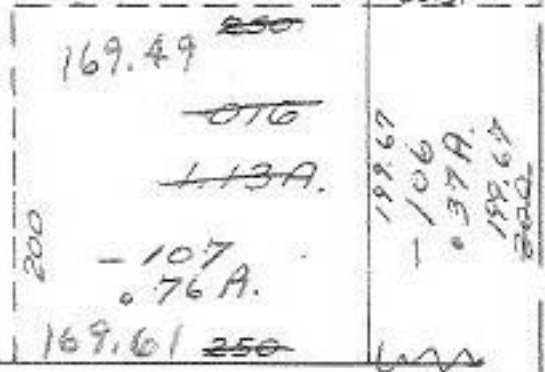

780.68 631.60 RD. 410.04 60.39

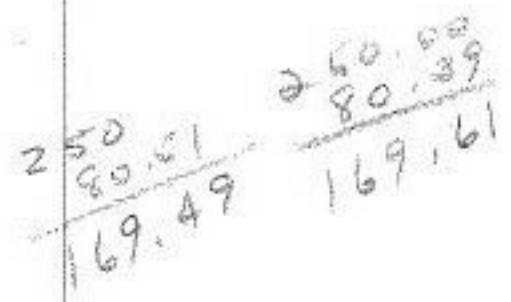

ELYRIA 680.46

10-000A-013-B

SPD

09B
097A

9718