



Handwritten initials or mark in the top left corner.

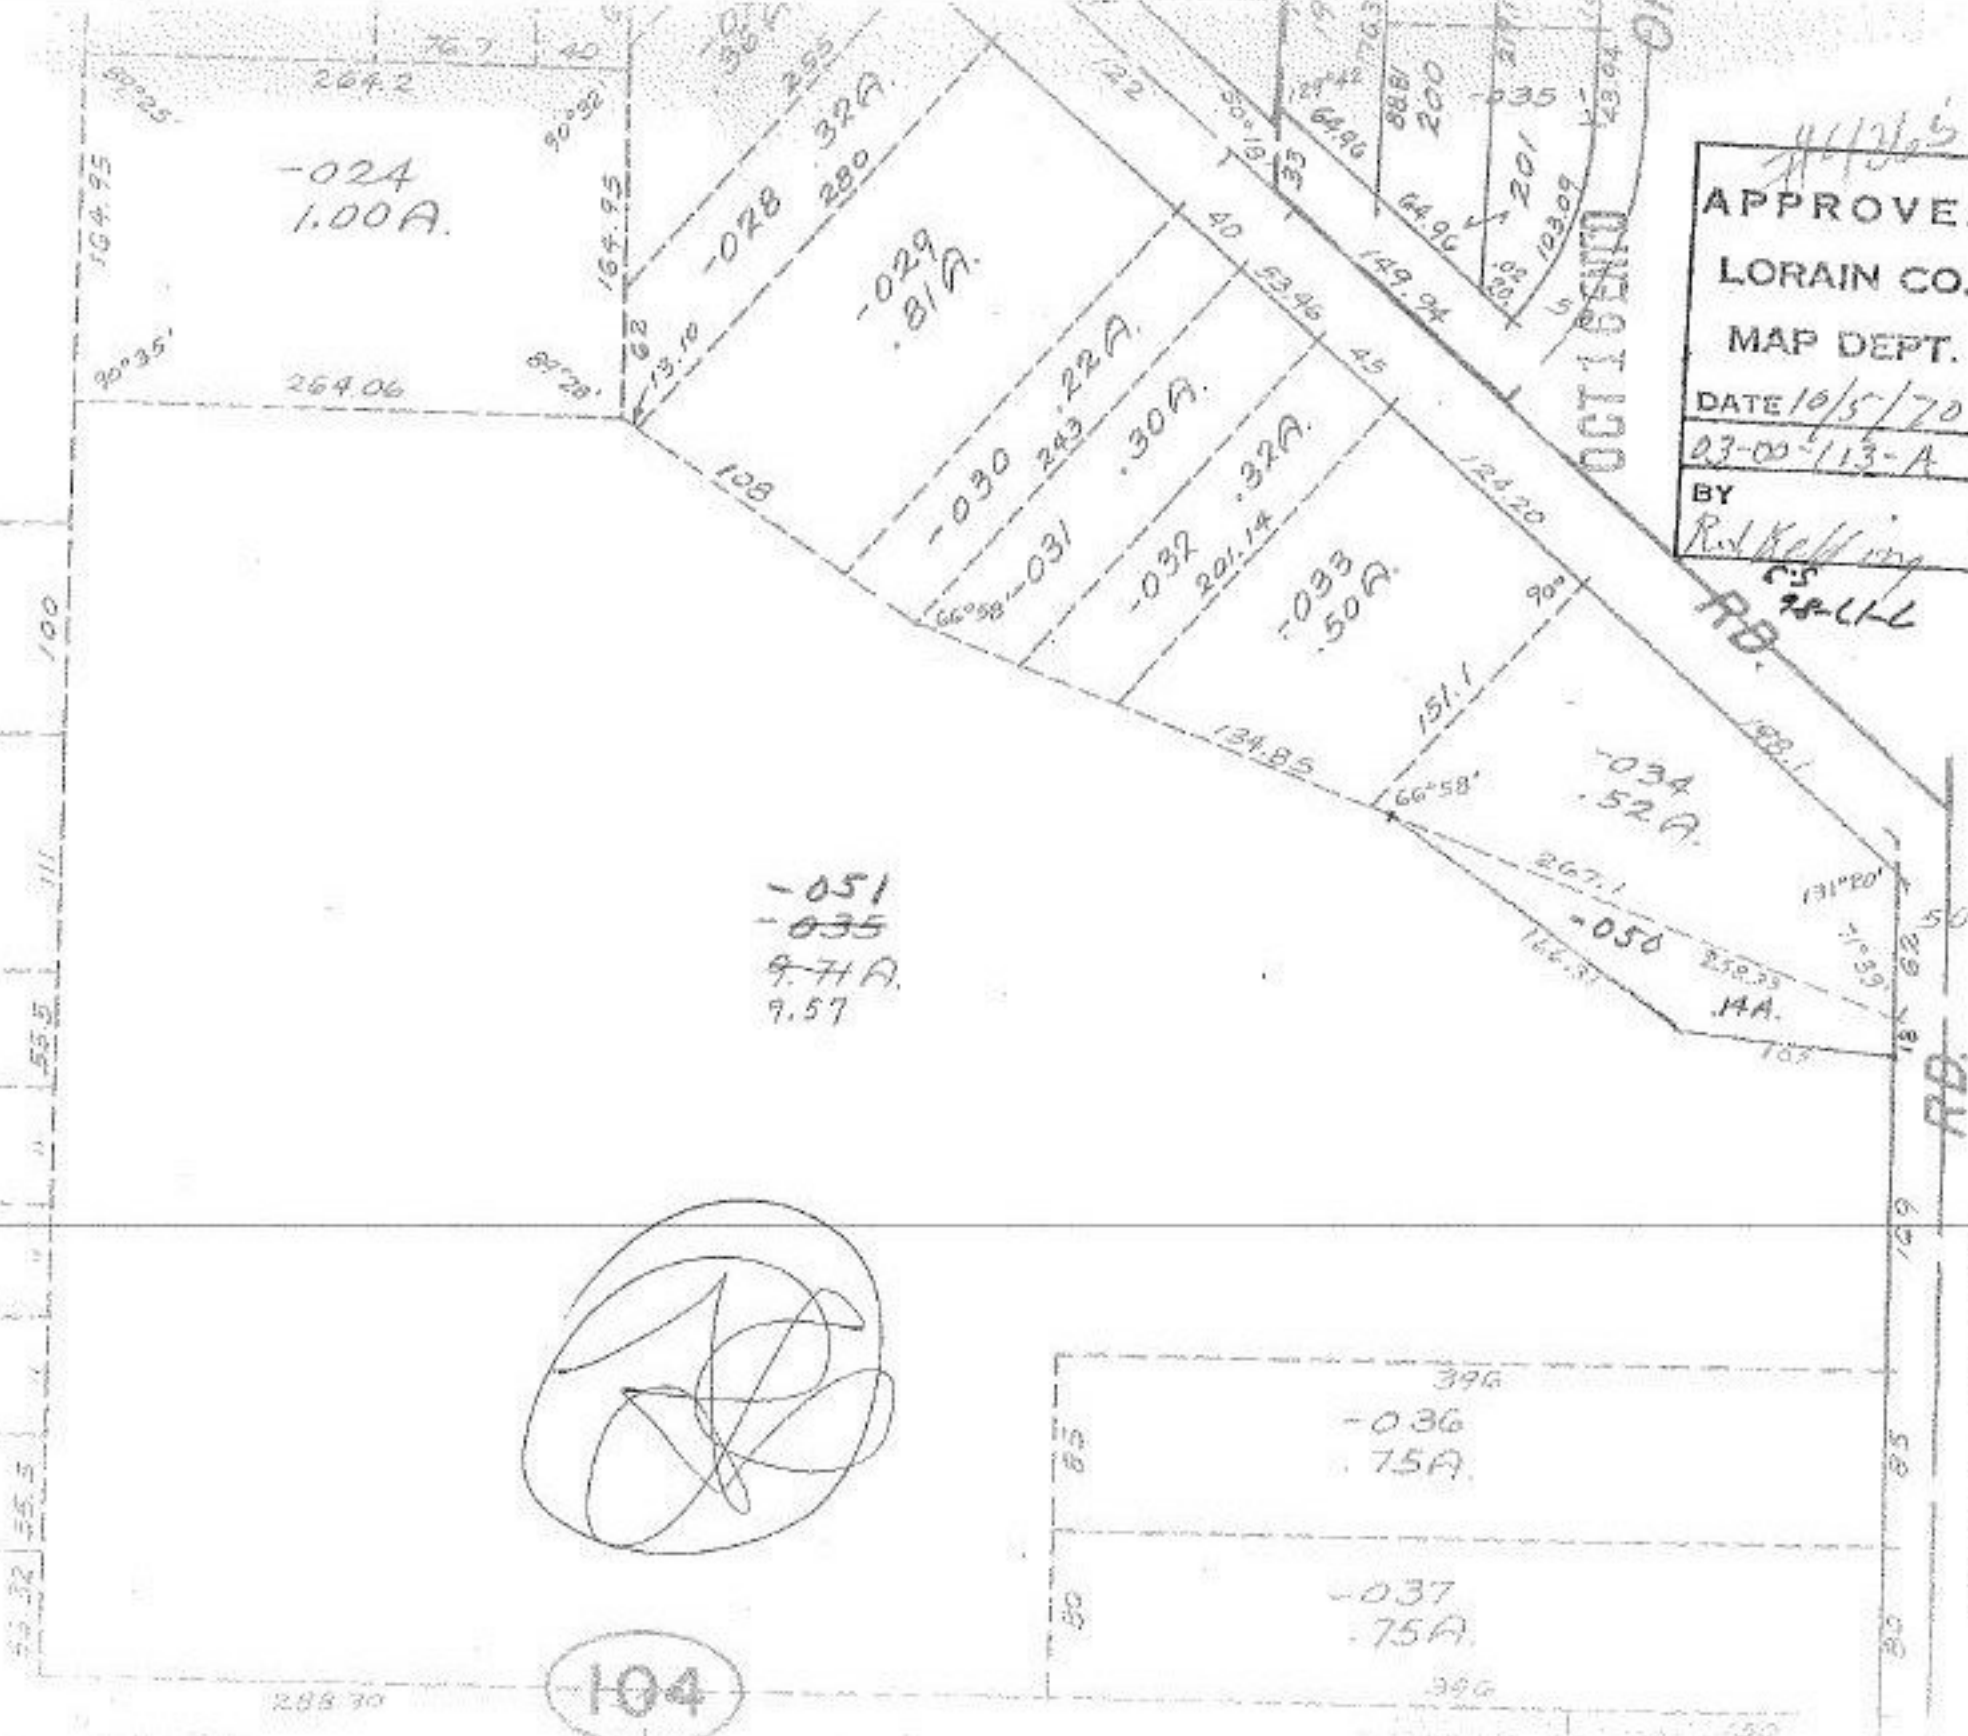

4/12/05
APPROVED
LORAIN CO.
MAP DEPT.
 DATE 10/5/70
 03-00-113-A
 BY
 R. J. Keating
 C.S.
 28-11-6

SEE 3-00-113-B

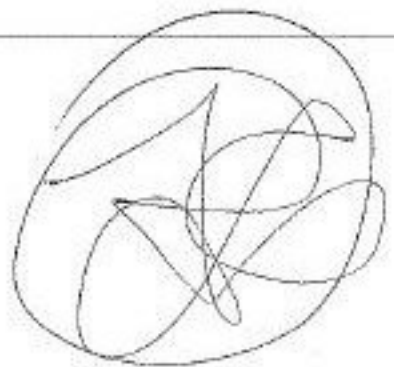

104

