


4391

OCT 27 ENTD

APPROVED
 LORAIN CO.
 MAP DEPT.
 DATE 10/13/70
 6-25
 BY
Paul Kelling

4391

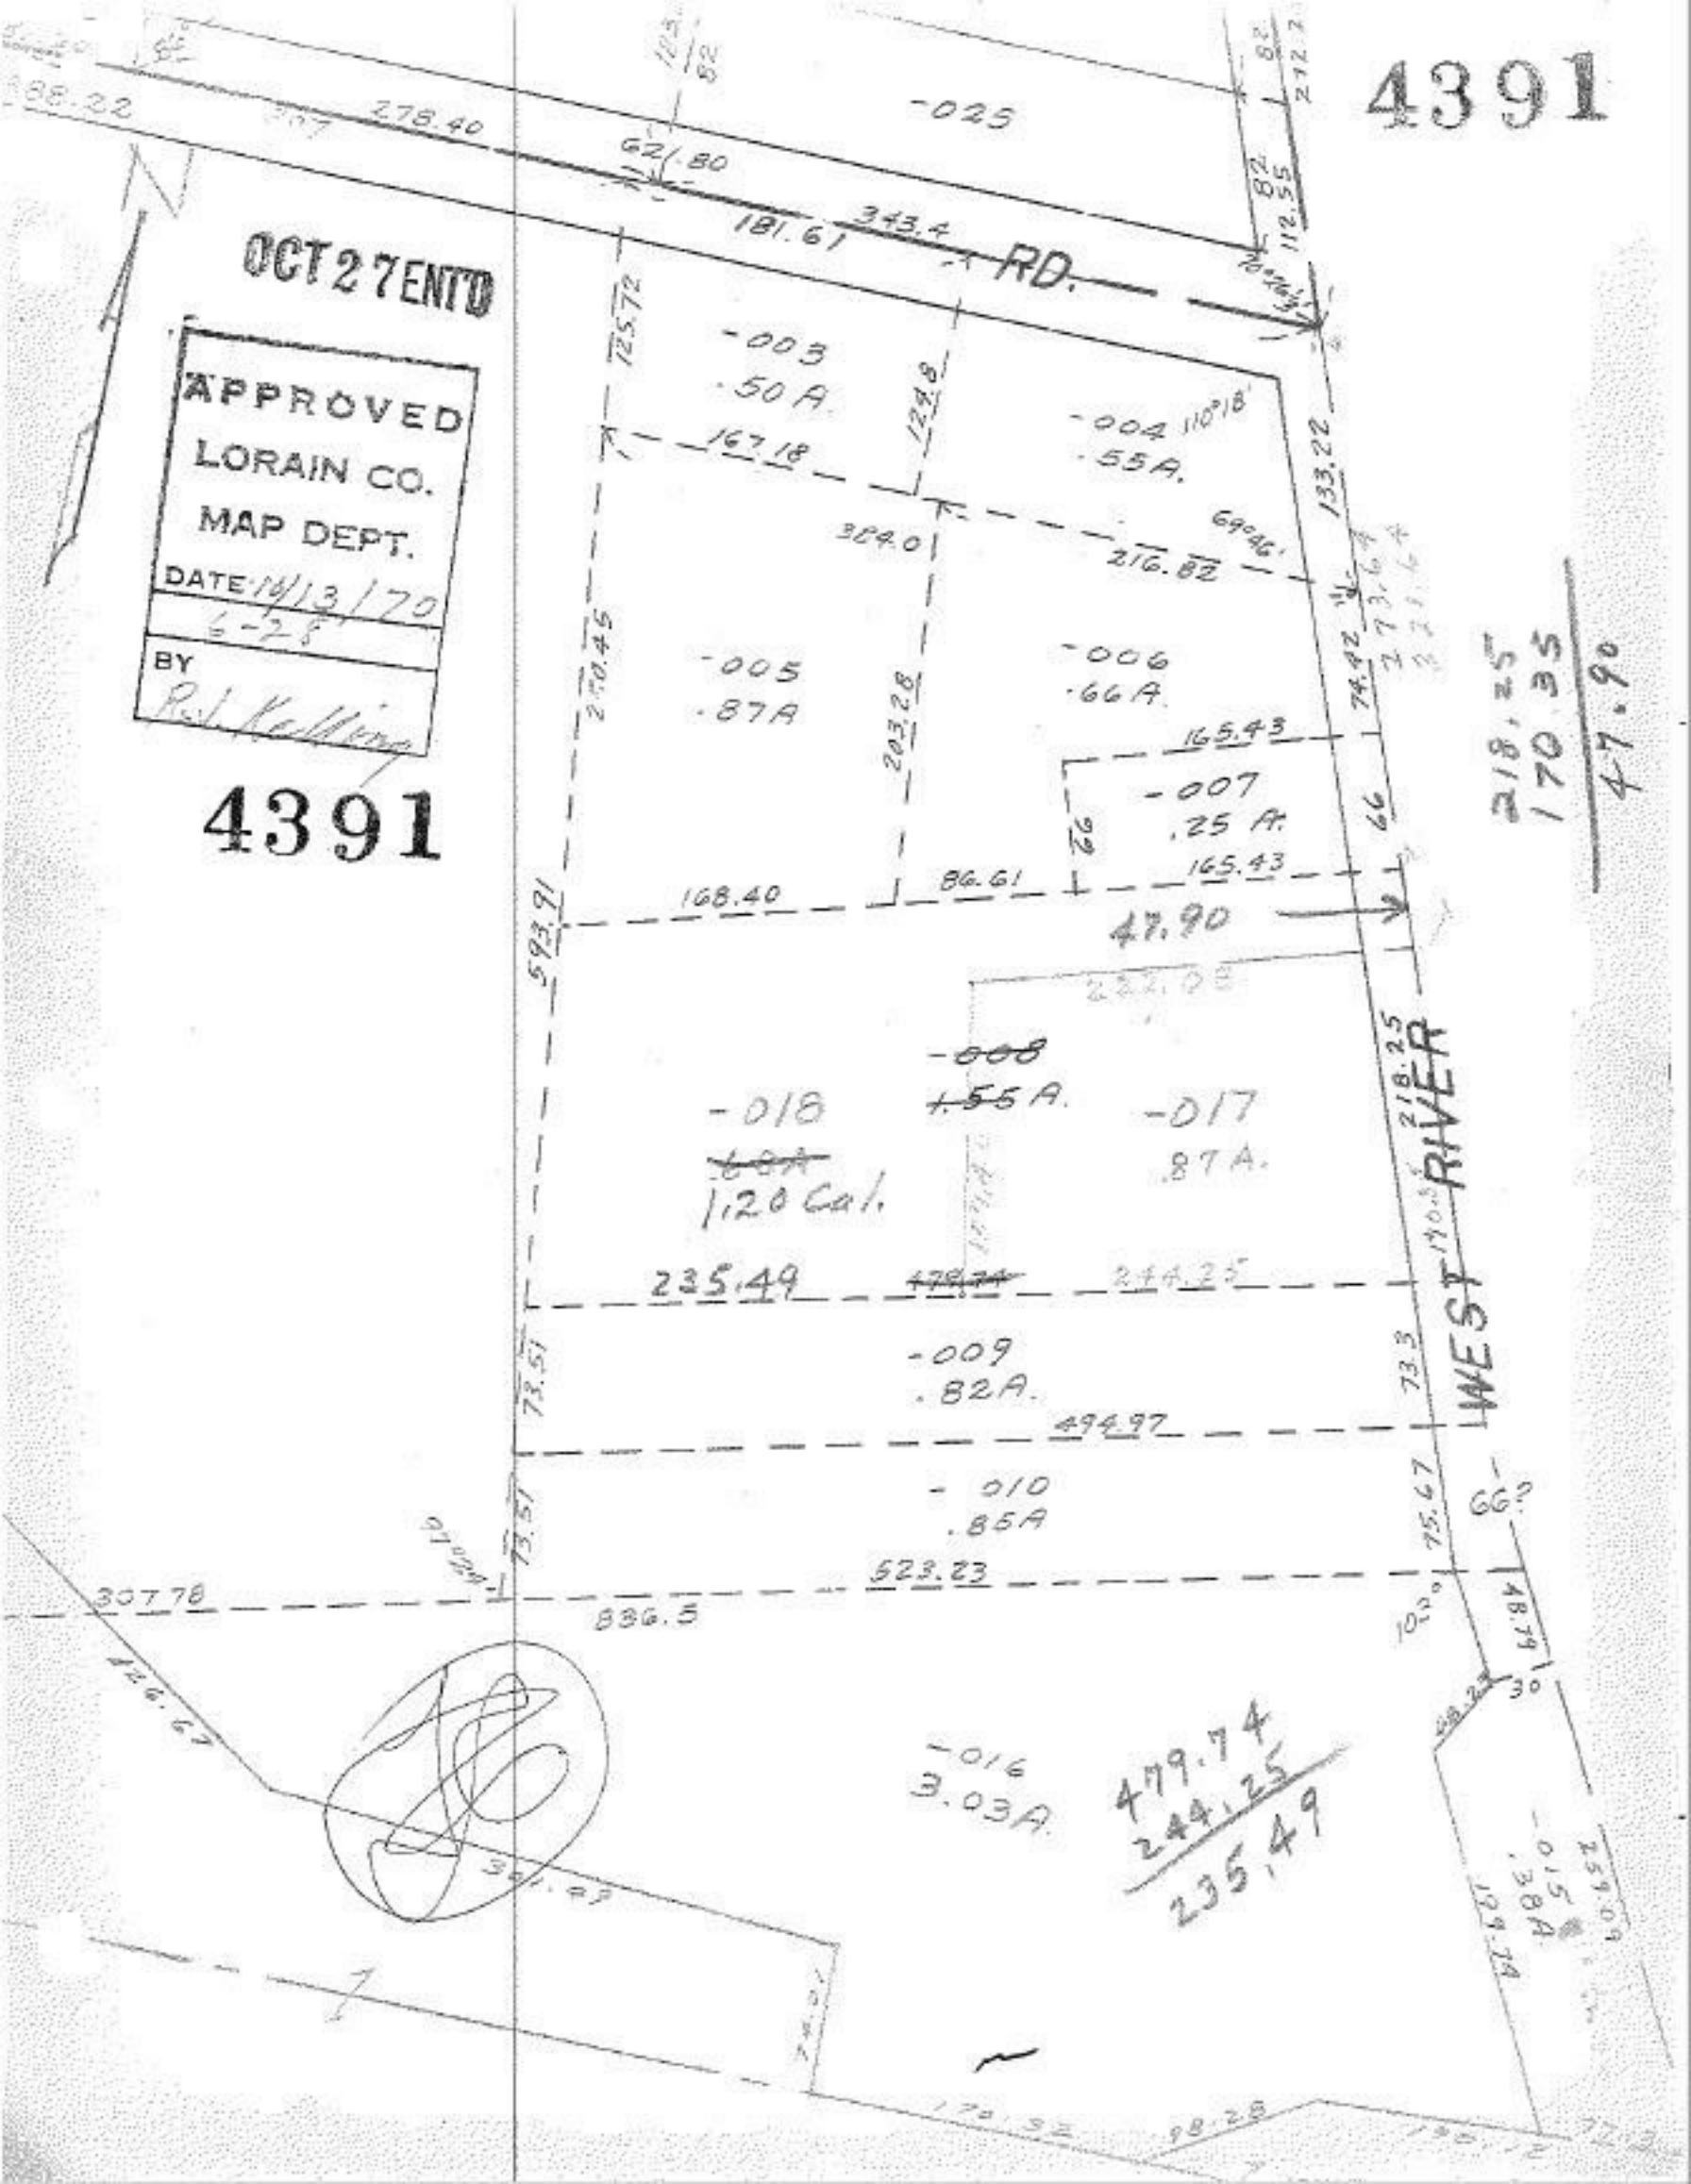

218.25
 170.35
 47.90

479.74
 244.25
 235.49