


4372

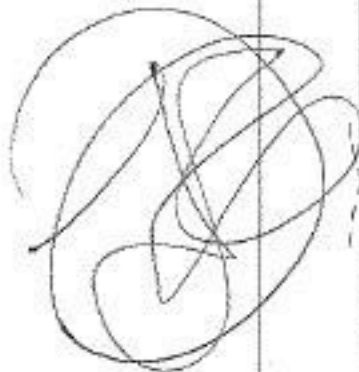

See
#2255
Note Section

NOV 12 ENT'D

#4297

APPROVED


LORAIN CO.

MAP DEPT.

DATE 10-13-70

12-02-2004

BY [Signature]

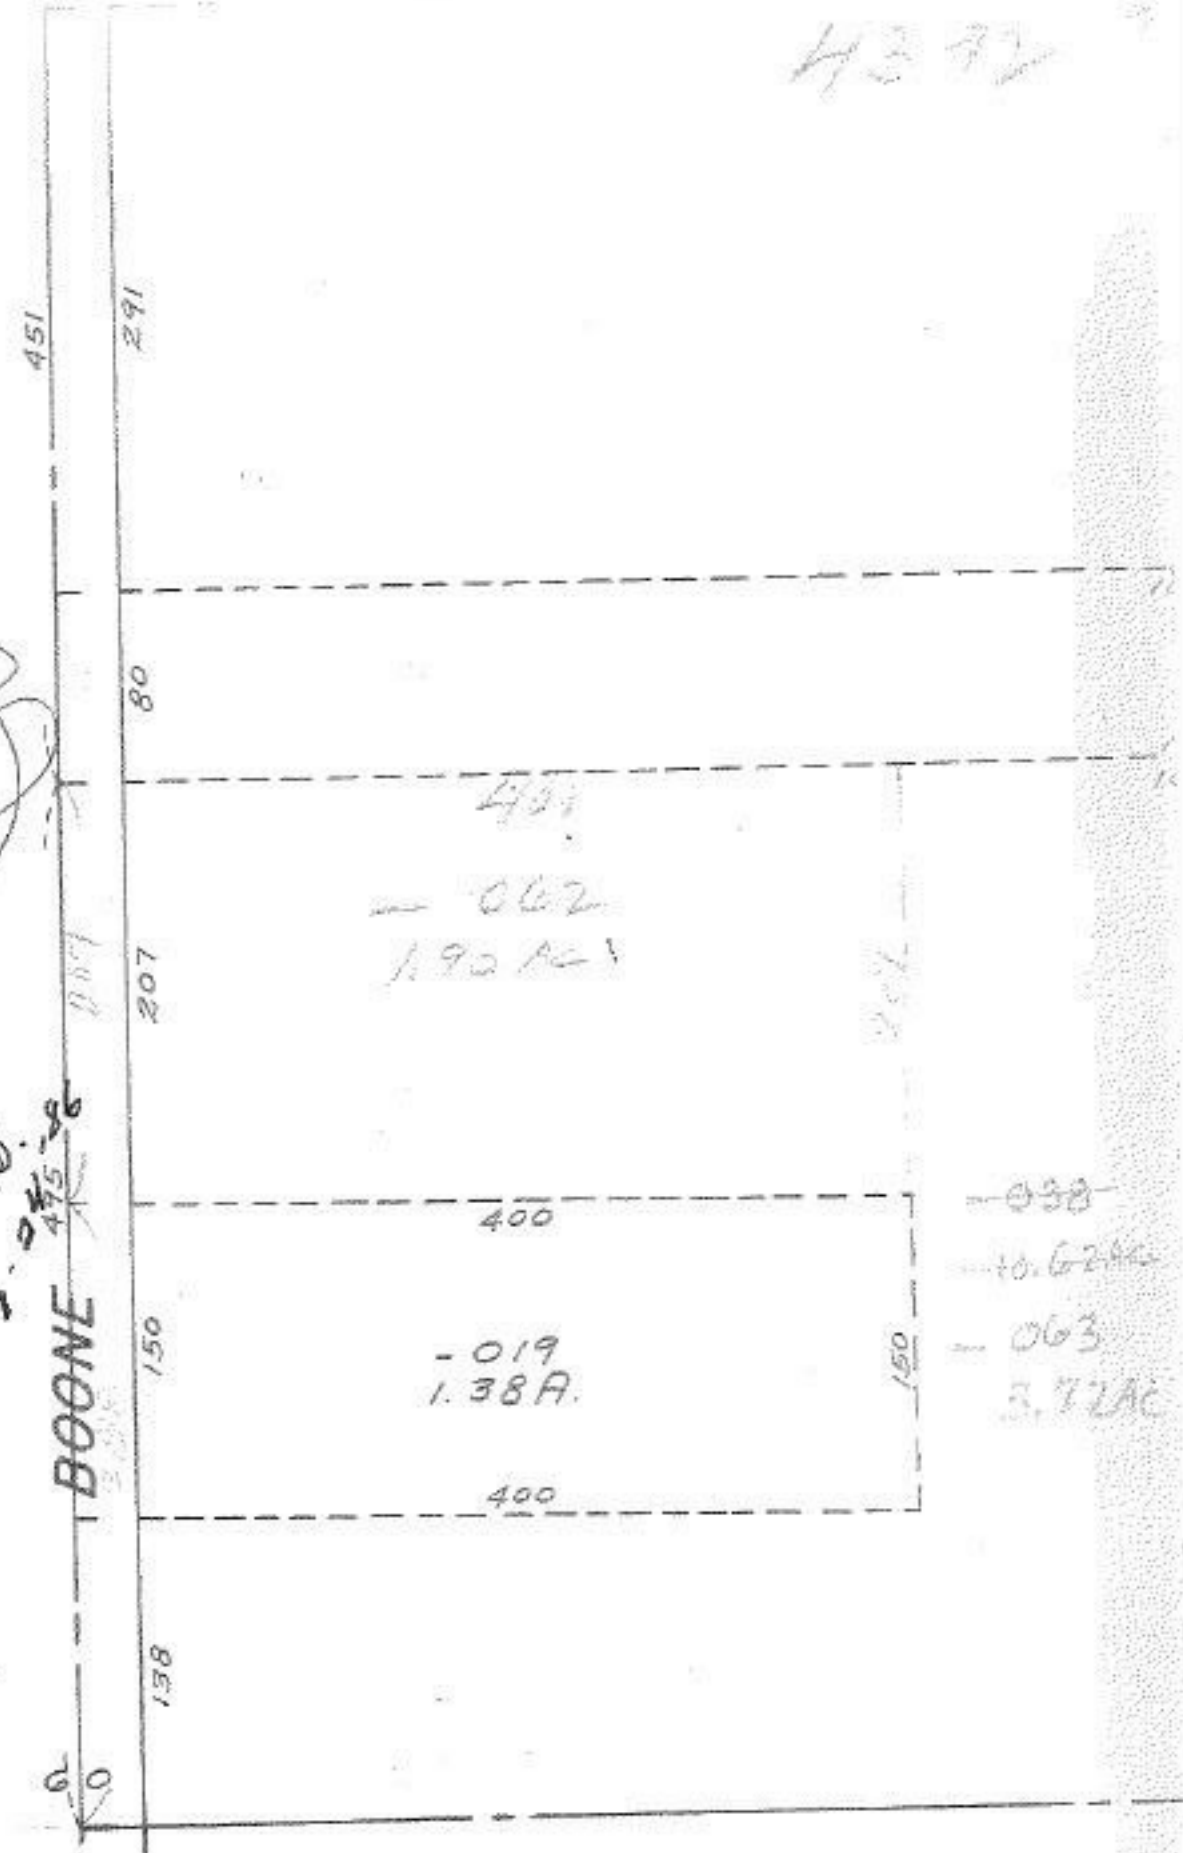

10-00-015A

-015 - A

COLUMBIA TWP

SCALE: 1" = 100'