




4405

APPROVED  
LORAIN CO.  
MAP DEPT.  
DATE 10-20-70  
3-00-001-A  
BY *Hollard*

NOV 19 ENT'D

SEE 3-00-011-B 7-17-86 SS

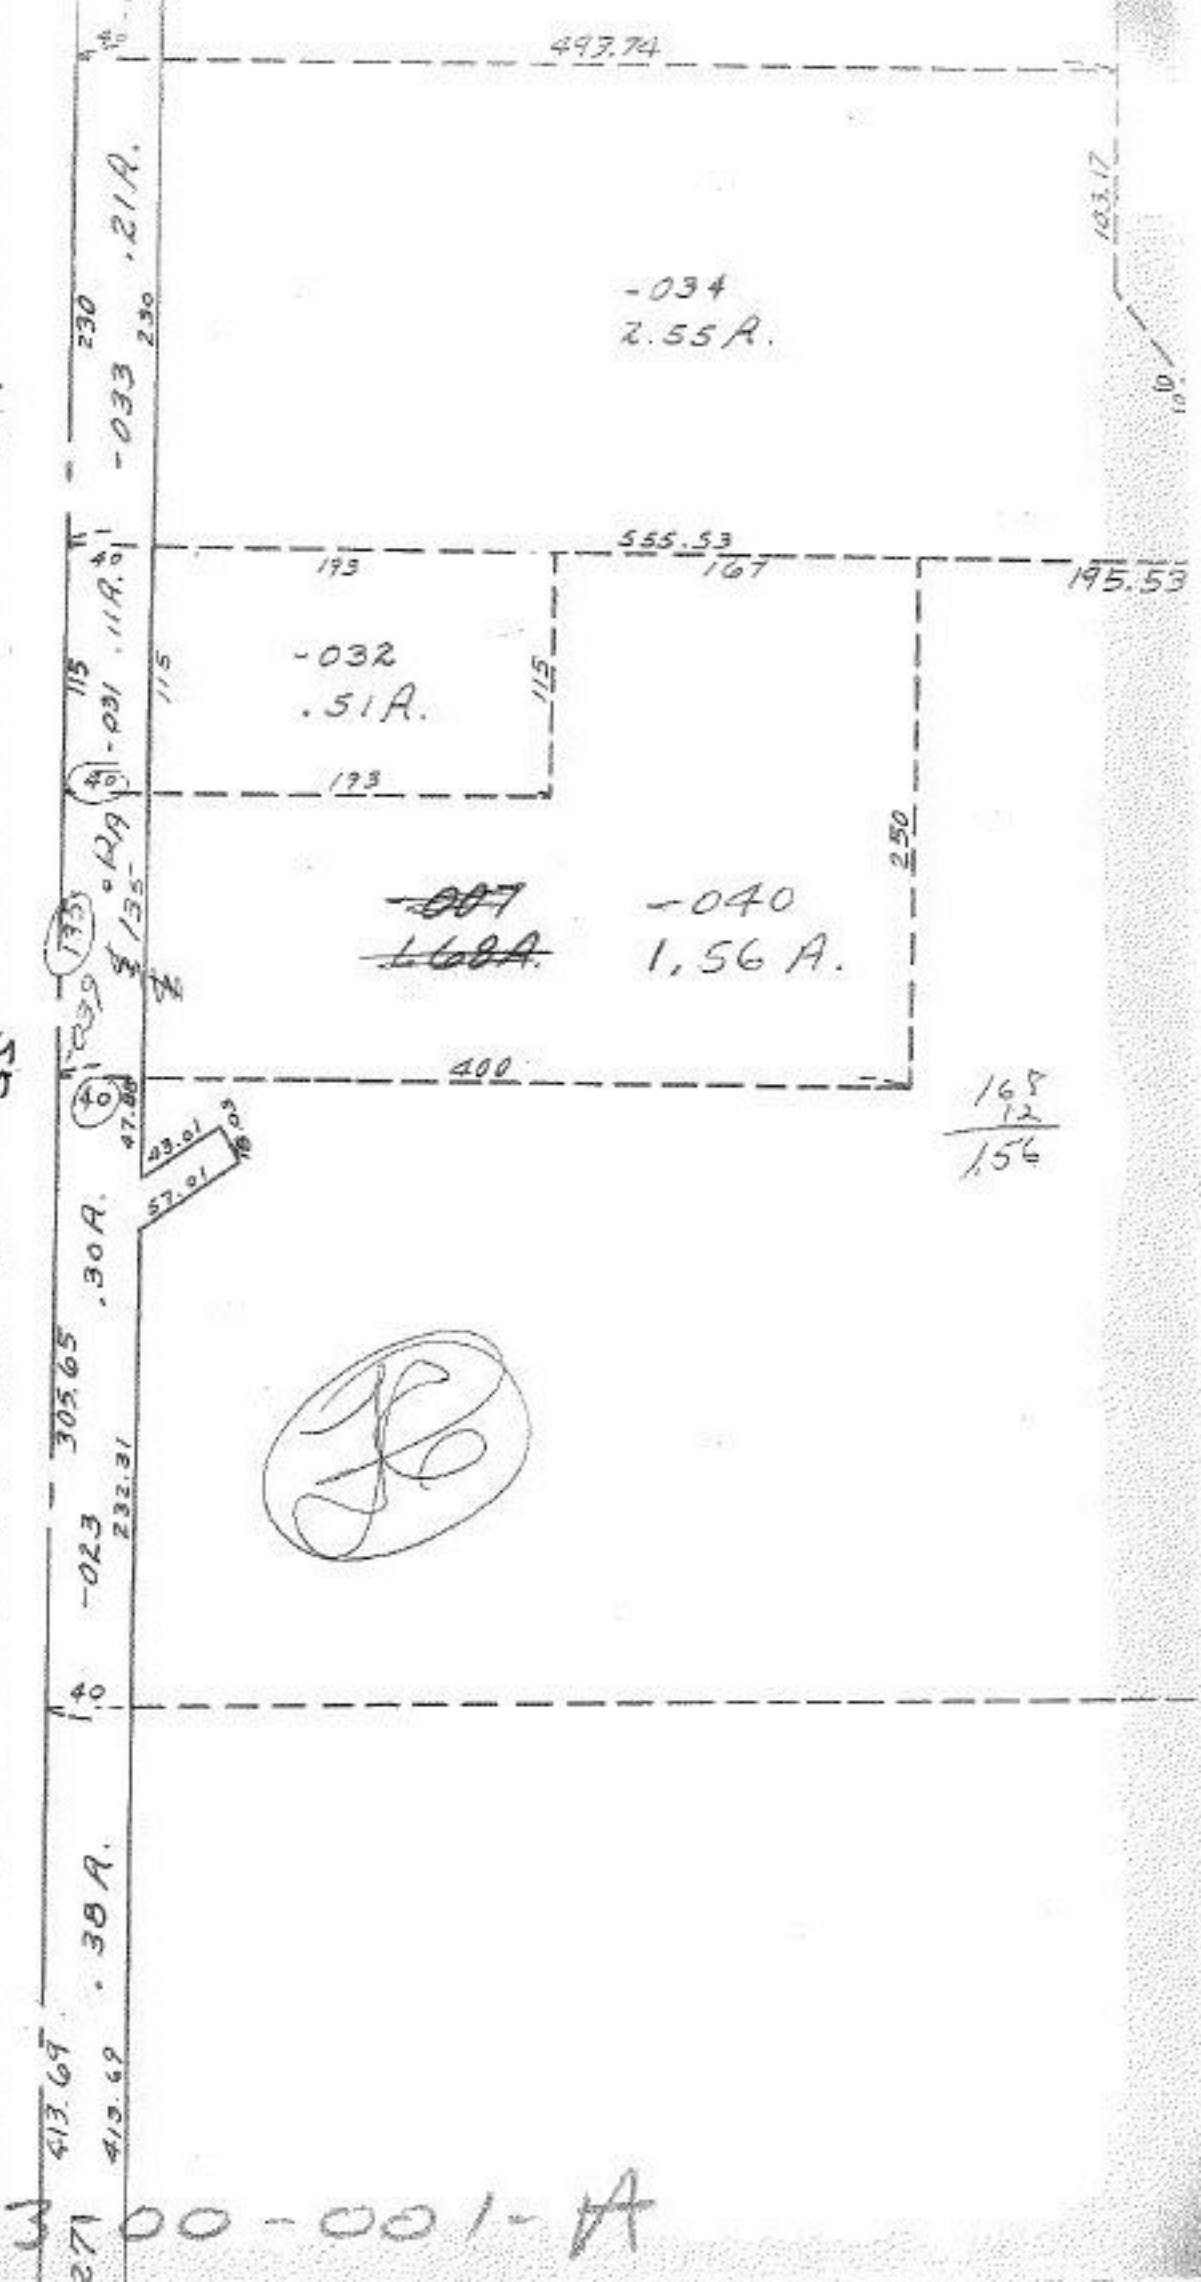

W 413.69  
271 413.69  
00-001-A