



4408

3

RD.

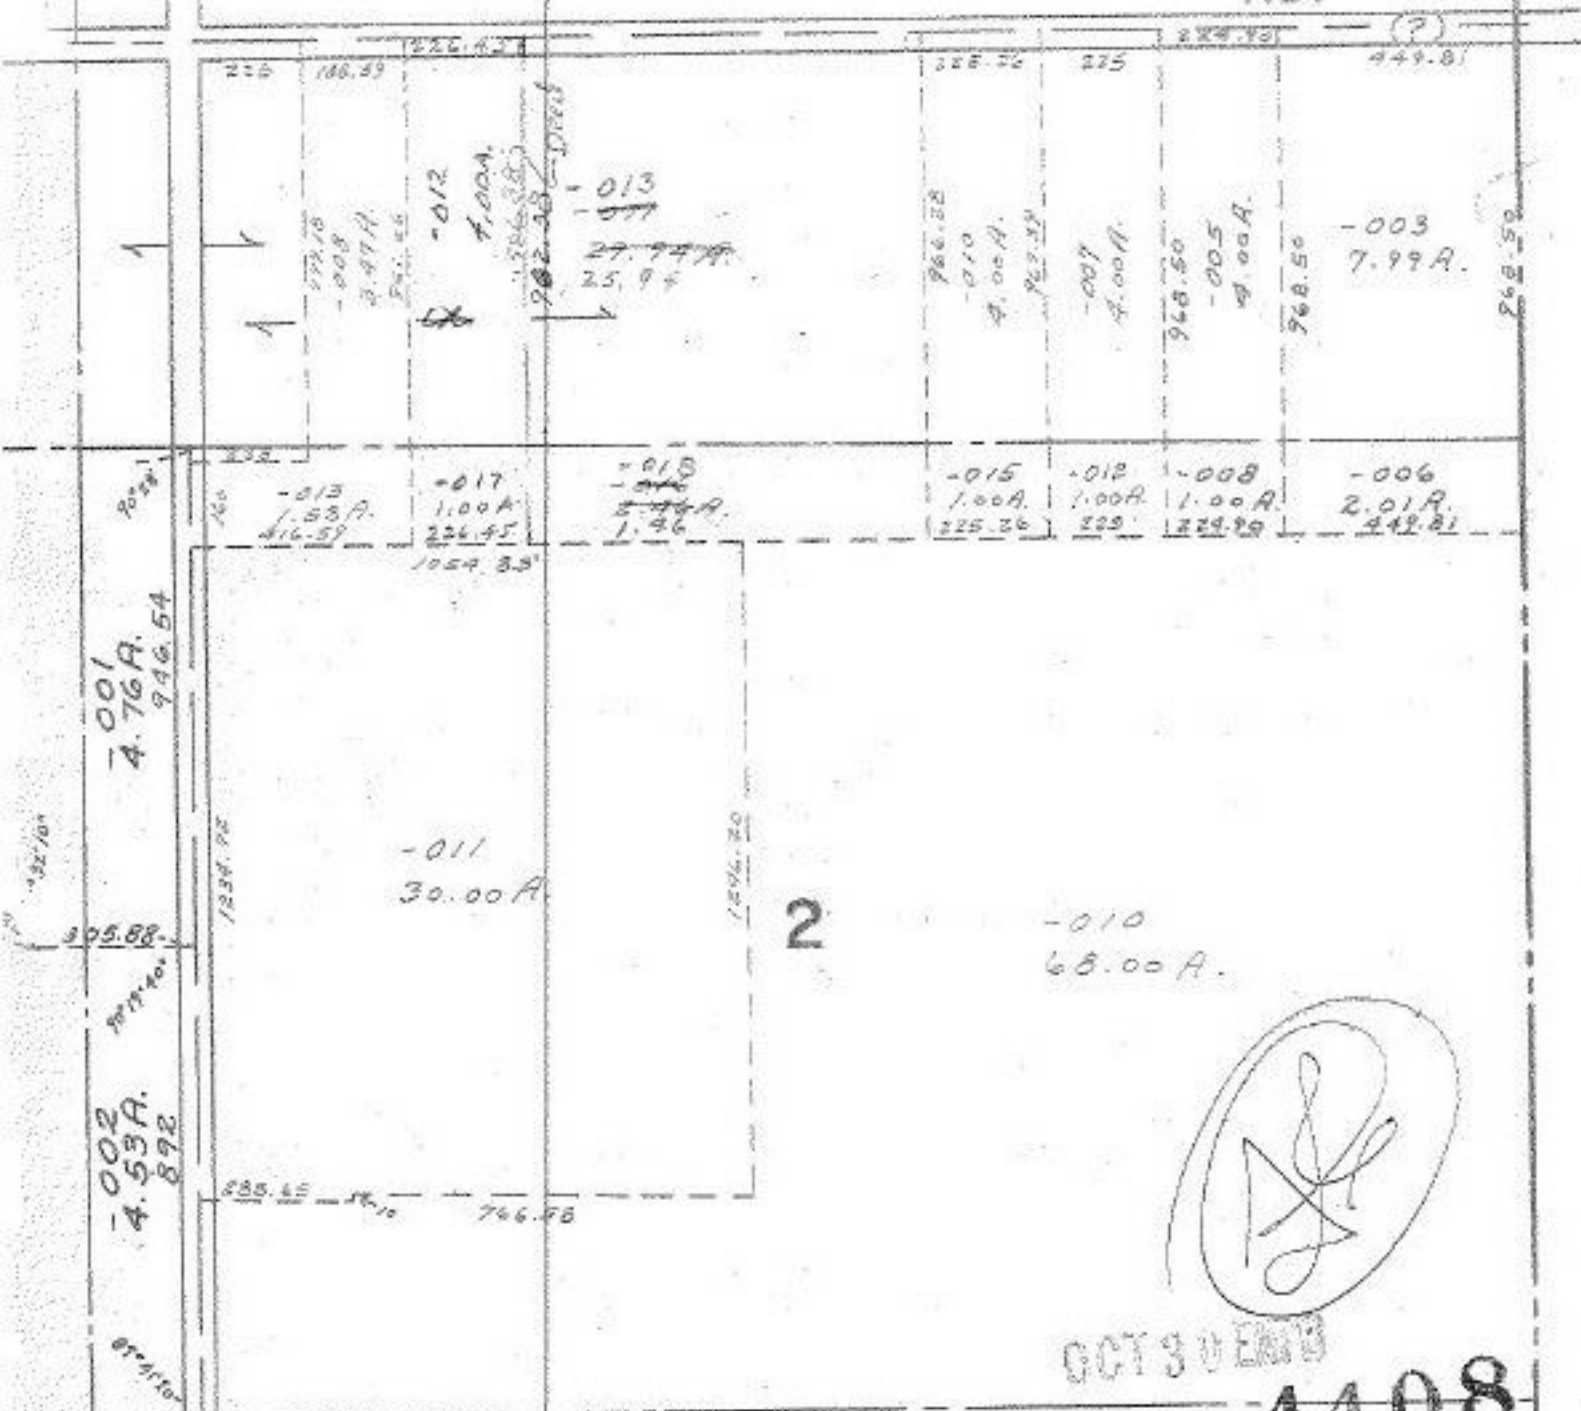

2

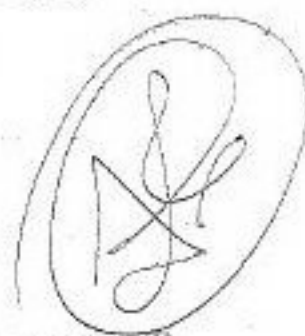

OCT 30 1933

4408

QUARRY

-001  
111.00 A.

APPROVED  
 LORAIN CO.  
 MAP DEPT.  
 DATE 10/15/33  
 20-D  
 BY  
 R. J. Kelling

S. J. A. 1/1/36