


4415

4415

APPROVED
 LORAIN CO.
 MAP DEPT.
 DATE 10/16/70
 11-00-084
 BY
 [Signature]

OCT 30 1970

J. S. [Signature]

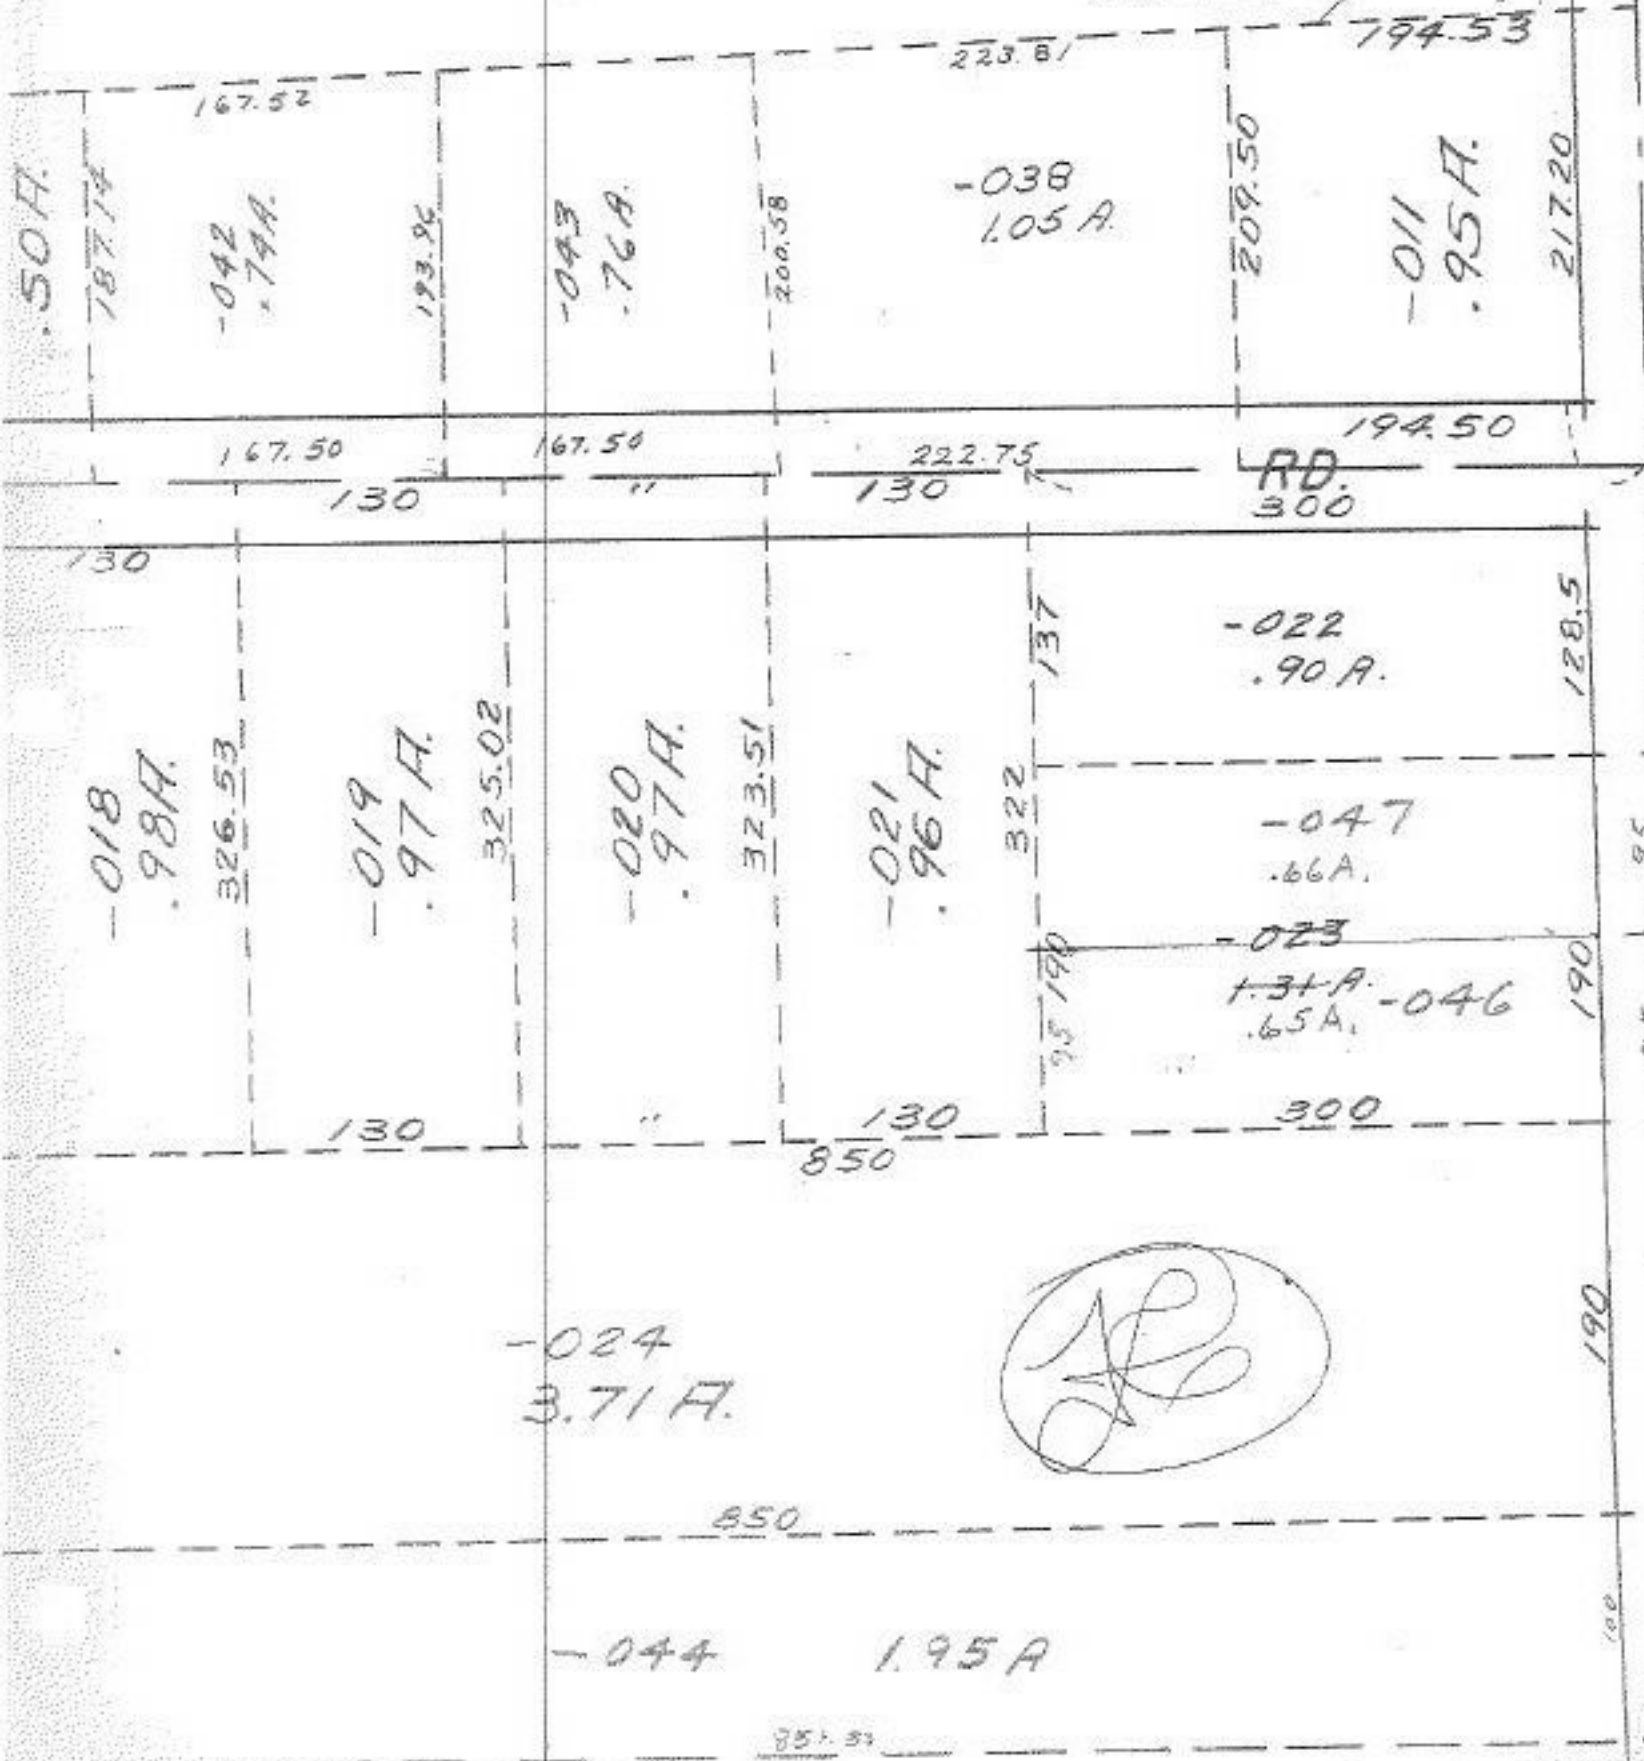

SEE 11-00-077-A

6542