

4420

NOV 20 1970


APPROVED  
LORAIN CO.  
MAP DEPT.

DATE 10/19/70  
21-E

BY  
R. J. Kelling

4420

J. D.  
8-1-88 001  
35.98A.

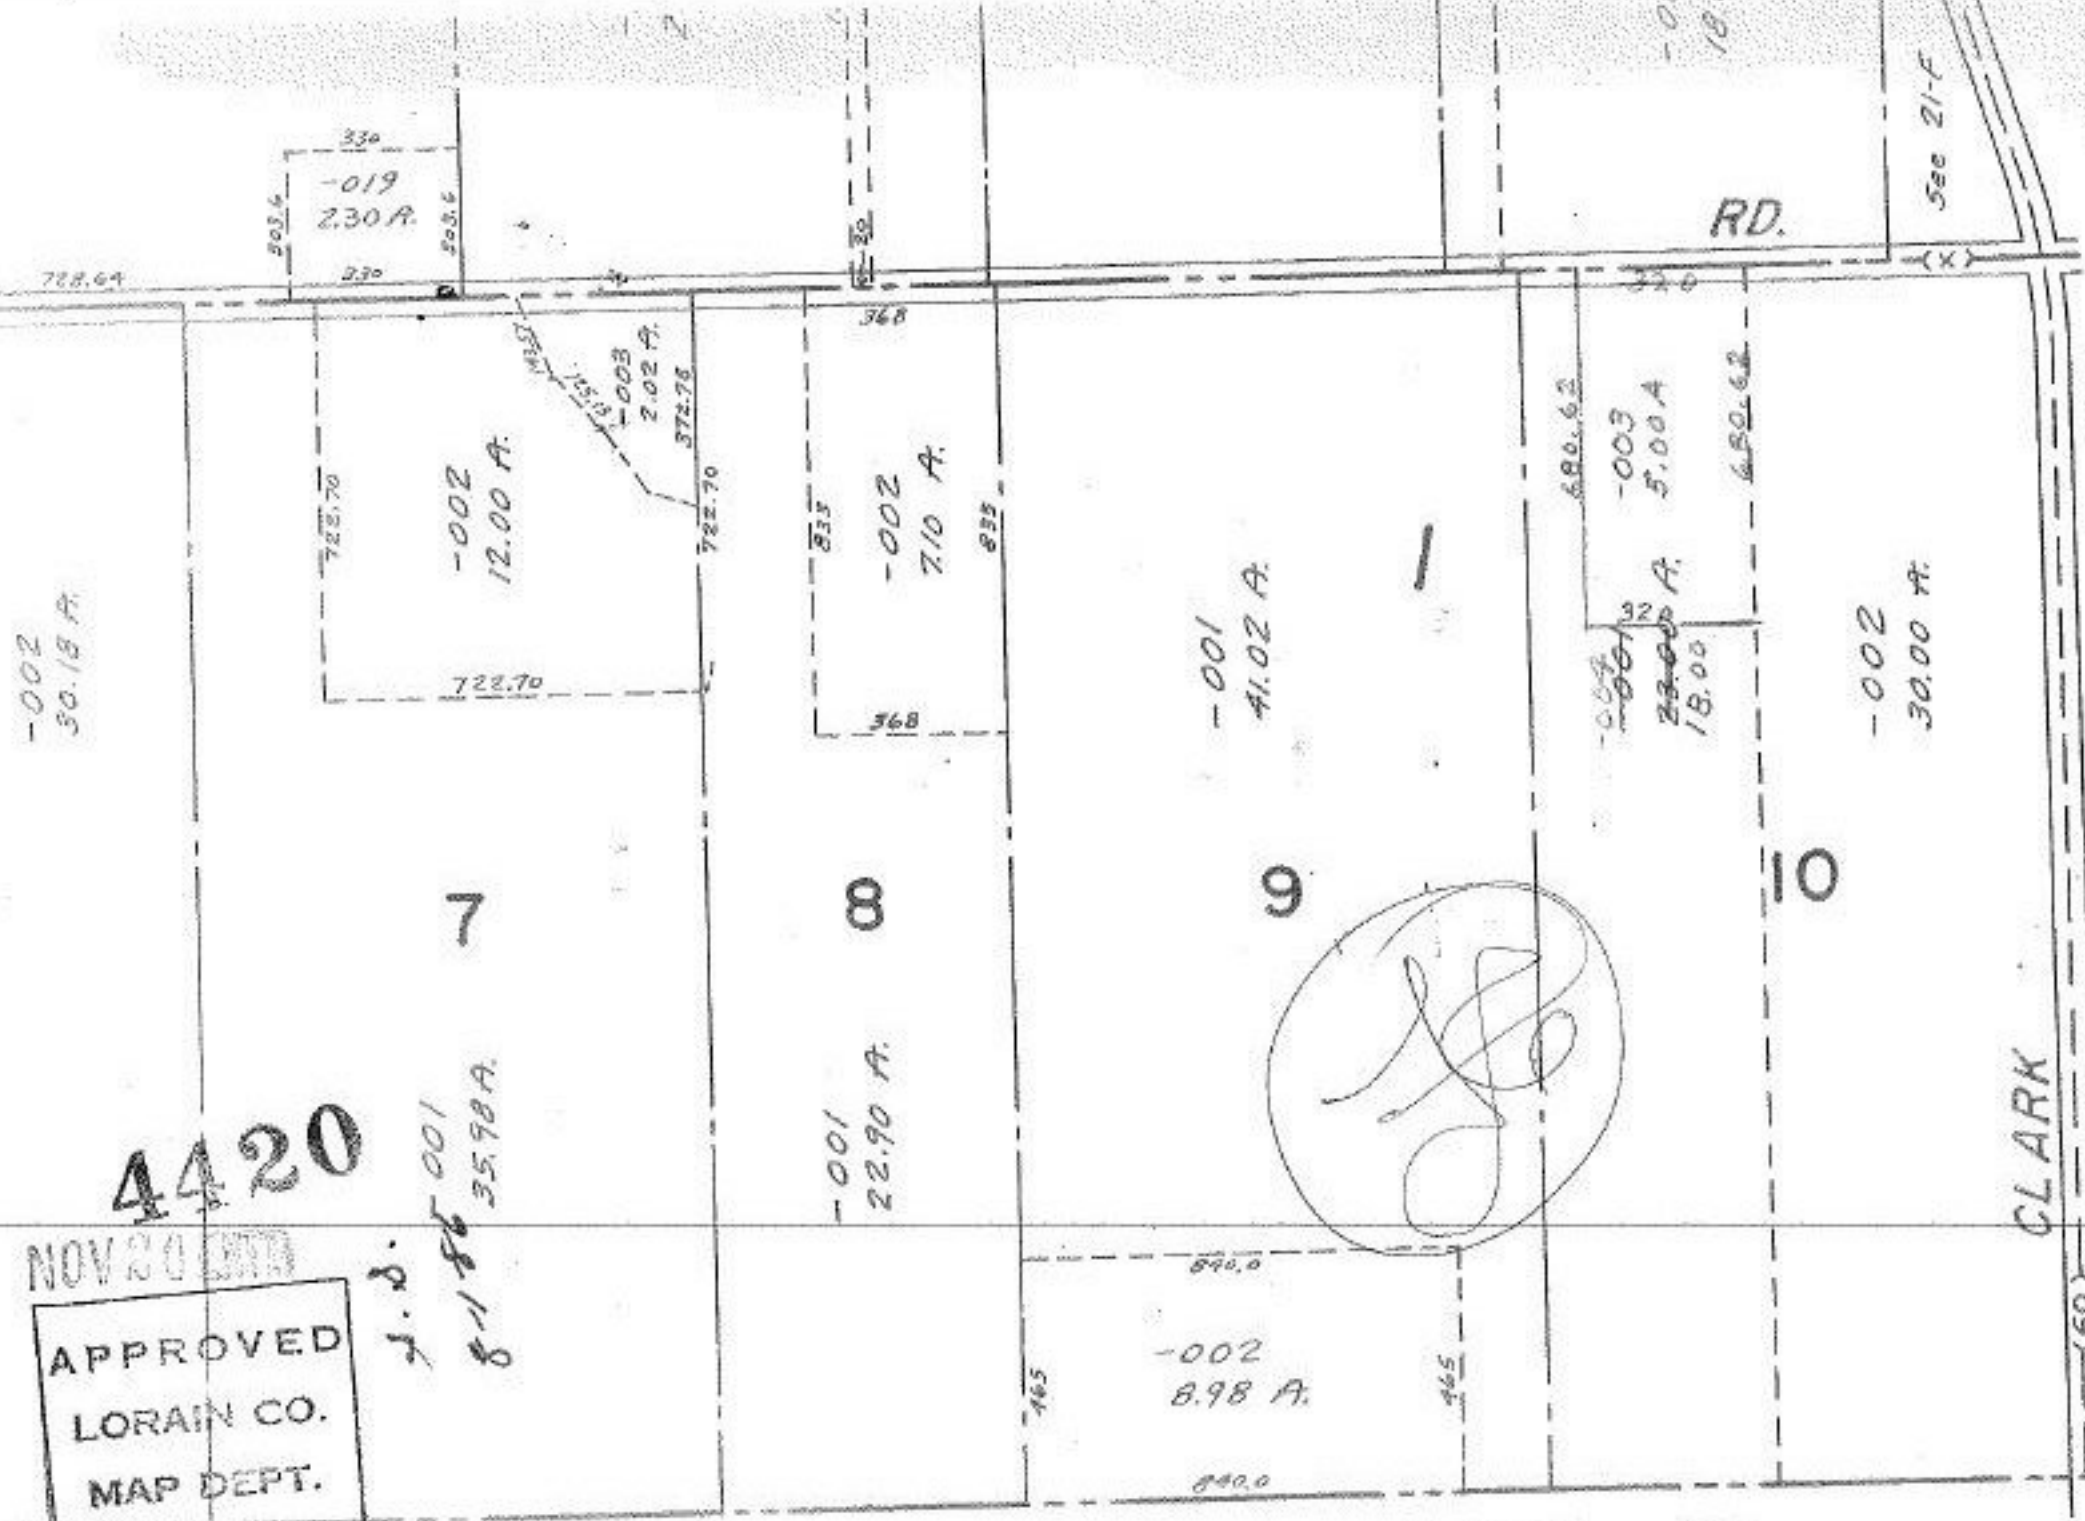

TRACT 1 LOTS 1 THRU 10  
 " 2 " 13 " 20  
 WLY. PT. TR. CTS 3 & 4

CLARK

See 21-F

RD.

(60)