

4422

SEE 5-G

392.10
350

-010
.59R.

-011
1.05R.

-012
1.00R.

350

-013
1.00R.

350

-014
1.00R.

-015
.50R.

-016
.50R.

-017
1.00R.

-018
1.00R.

75.2

60

198

RD.

133

126.13

368.4

169.90

169.9

36

38

83

124.5

274.90

274.9

184.27

130

-021
3.69R.

-039

1.67R

377.40
379.50

118.74

88.06

356.25


-040

2.02

342.06

422.06

Nov 2-50 E

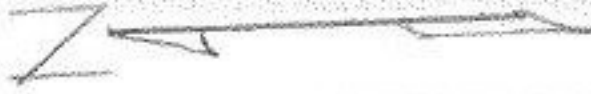

~~274.90~~
~~274.90~~

422.06

80

342.06

NOV 19 1950

APPROVED

LORAIN CO.


MAP DEPT.

DATE 10/19/50

5-00-253-B

BY

R. D. Welton

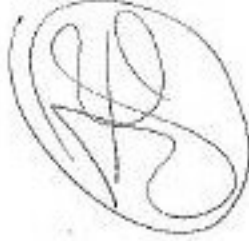

9-19-86 k.l.

-022

41.00R.