




-022

Map  
 Correction  
 4422

APPROVED  
 LORAIN CO.  
 MAP DEPT.  
 DATE 6-24-71  
 5-00-053-2  
 BY [Signature]

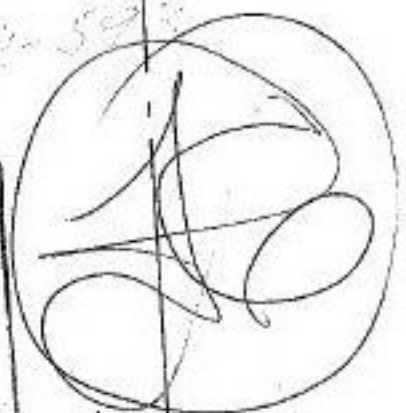

4422  
 [Signature]