

4447


NOV 19 ENT'D

APPROVED
 LORAIN CO.
 MAP DEPT.
 DATE 10/29/70
 7-00-009-C
 BY
 R. J. Kellum

-045
42.78A



990.07

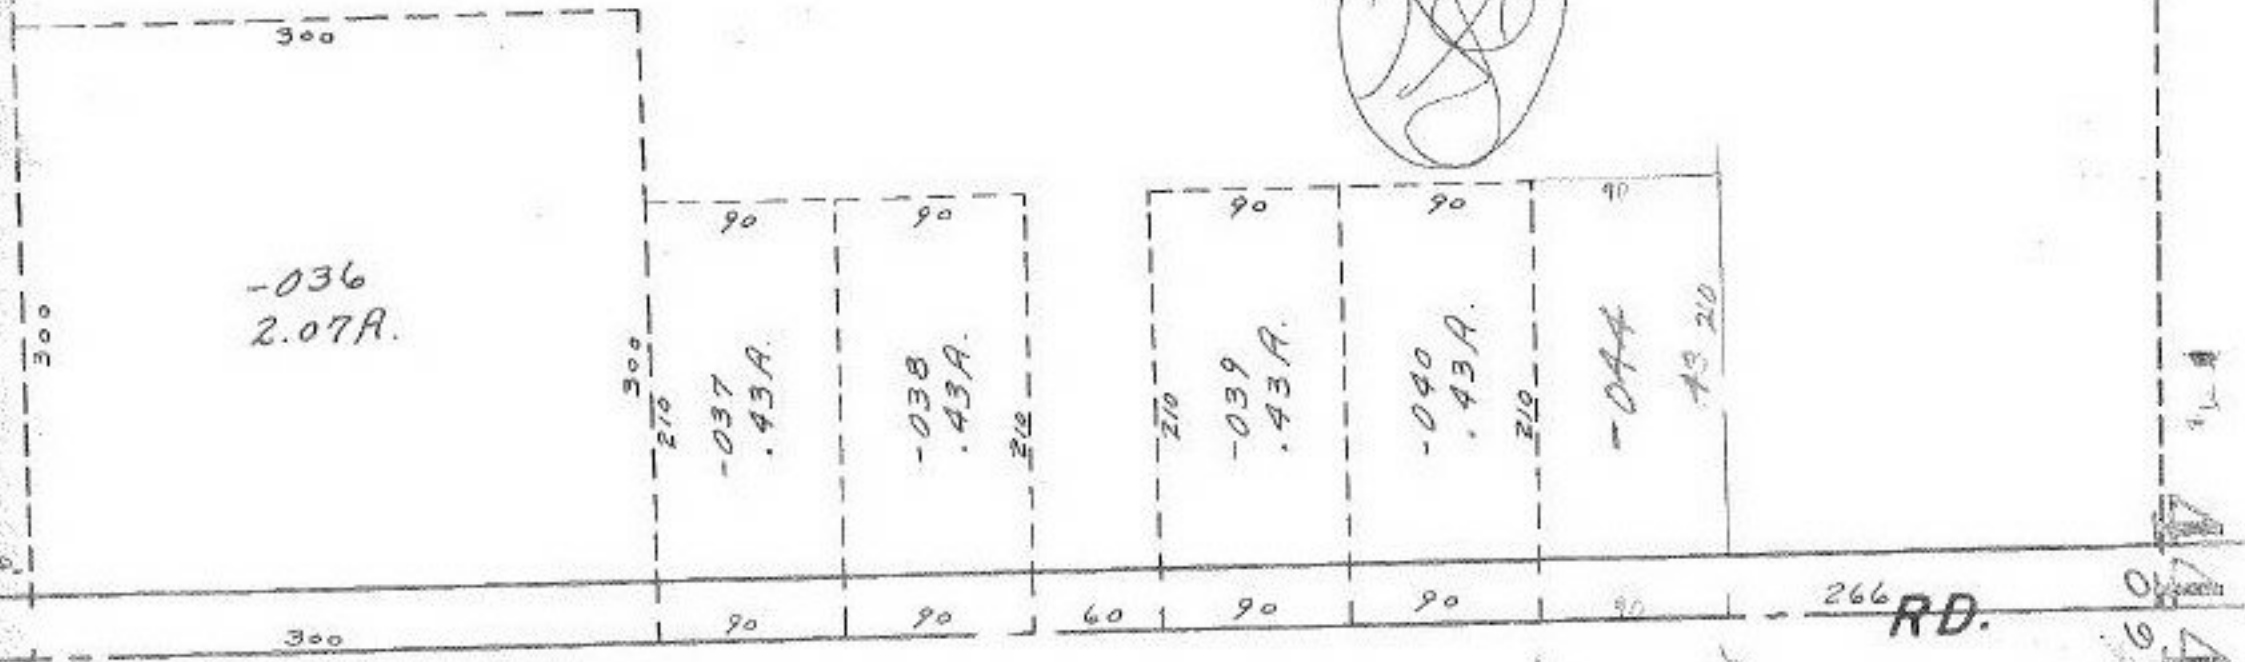

SEE 7-00-010-A

2400
~~2178~~

993.95

513.95

637.06

