


4457

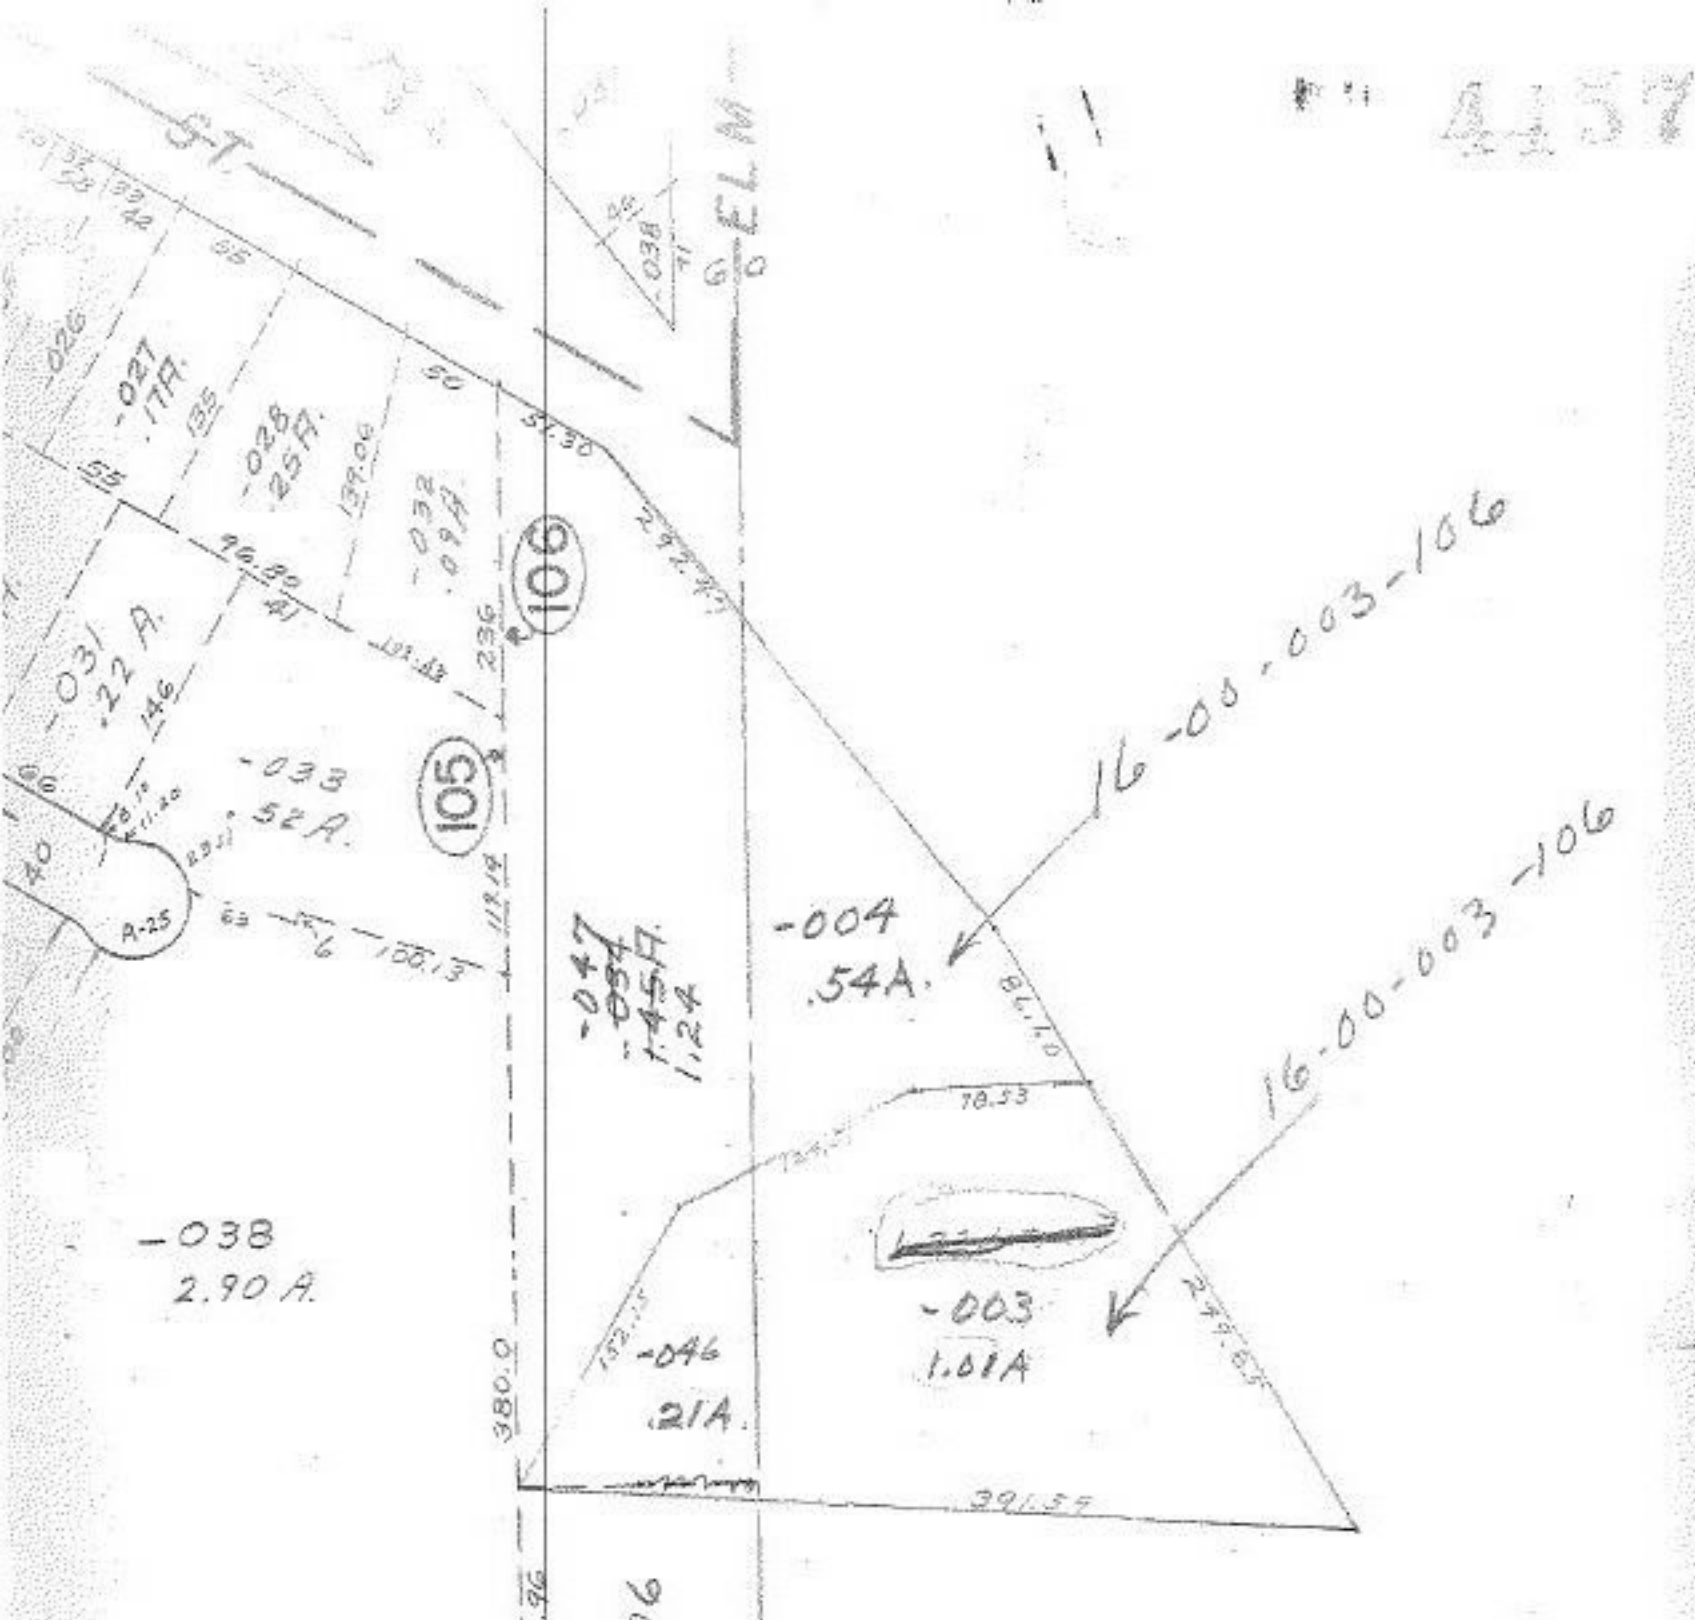

16-00-003-106

16-00-003-106

16-00-002-106

Village of Crafton
Mayor Tohill

521.40

4457
JAN 2 6 1910

APPROVED
LORAIN CO.
MAP DEPT.
DATE
16-00-001-D
16-00-002-A
BY
R. J. Kelling

