



4477

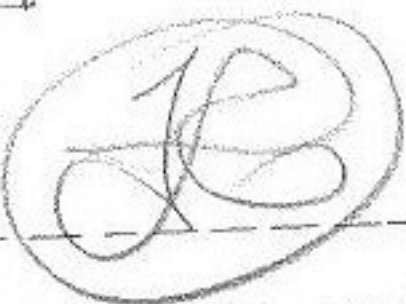

-026
97.55A

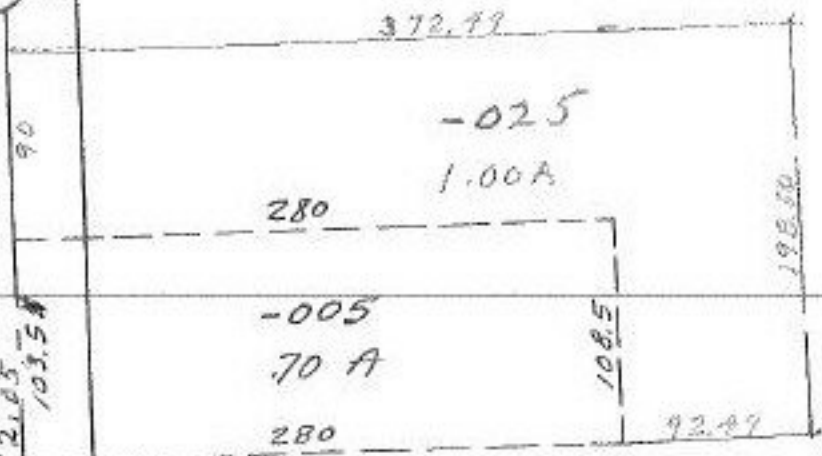

1325.28

4477
DEC 1 GENTL
7-5-66-6

APPROVED

LOWAN CO.

MAP DEPT.

DATE 11/18/70

17-07-008-A

BY
R. B. King

4477