


4501
4501

SEE 4-

MOORE

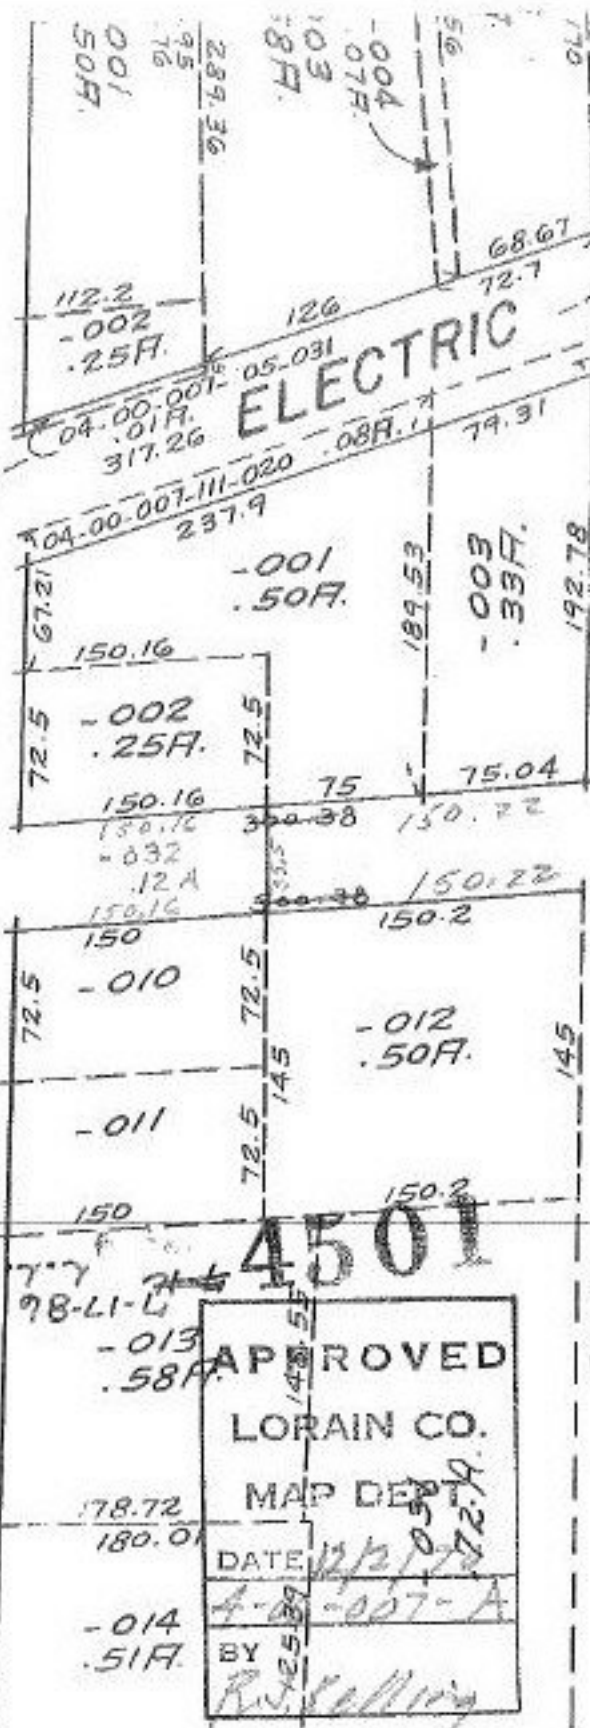

ELECTRIC

JAN 5 ENT'D

4501


APPROVED
LORAIN CO.
MAP DEPT.

DATE 12/21/72

BY R. J. Kelling

300:38
150:16
150:22

III

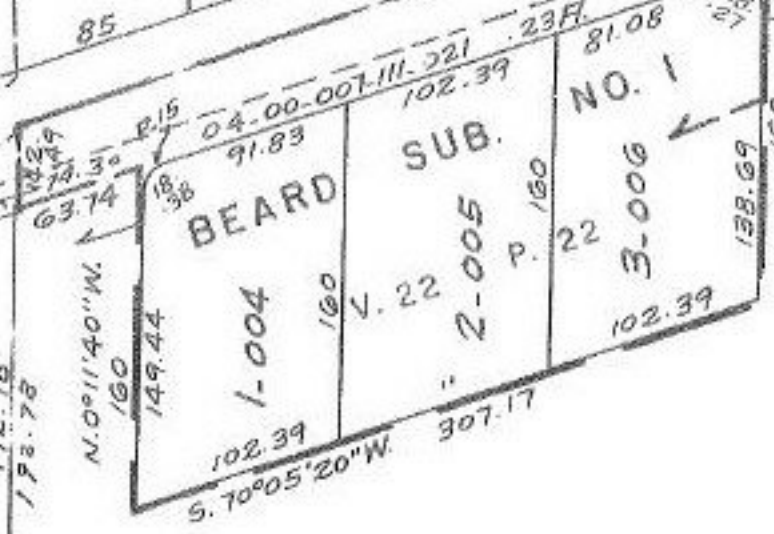

672.85

ORCHA

6-0

139.20

130

-0

139

85

85

ORC

139

85

104.87