


4503


SEE 5-00-033-B

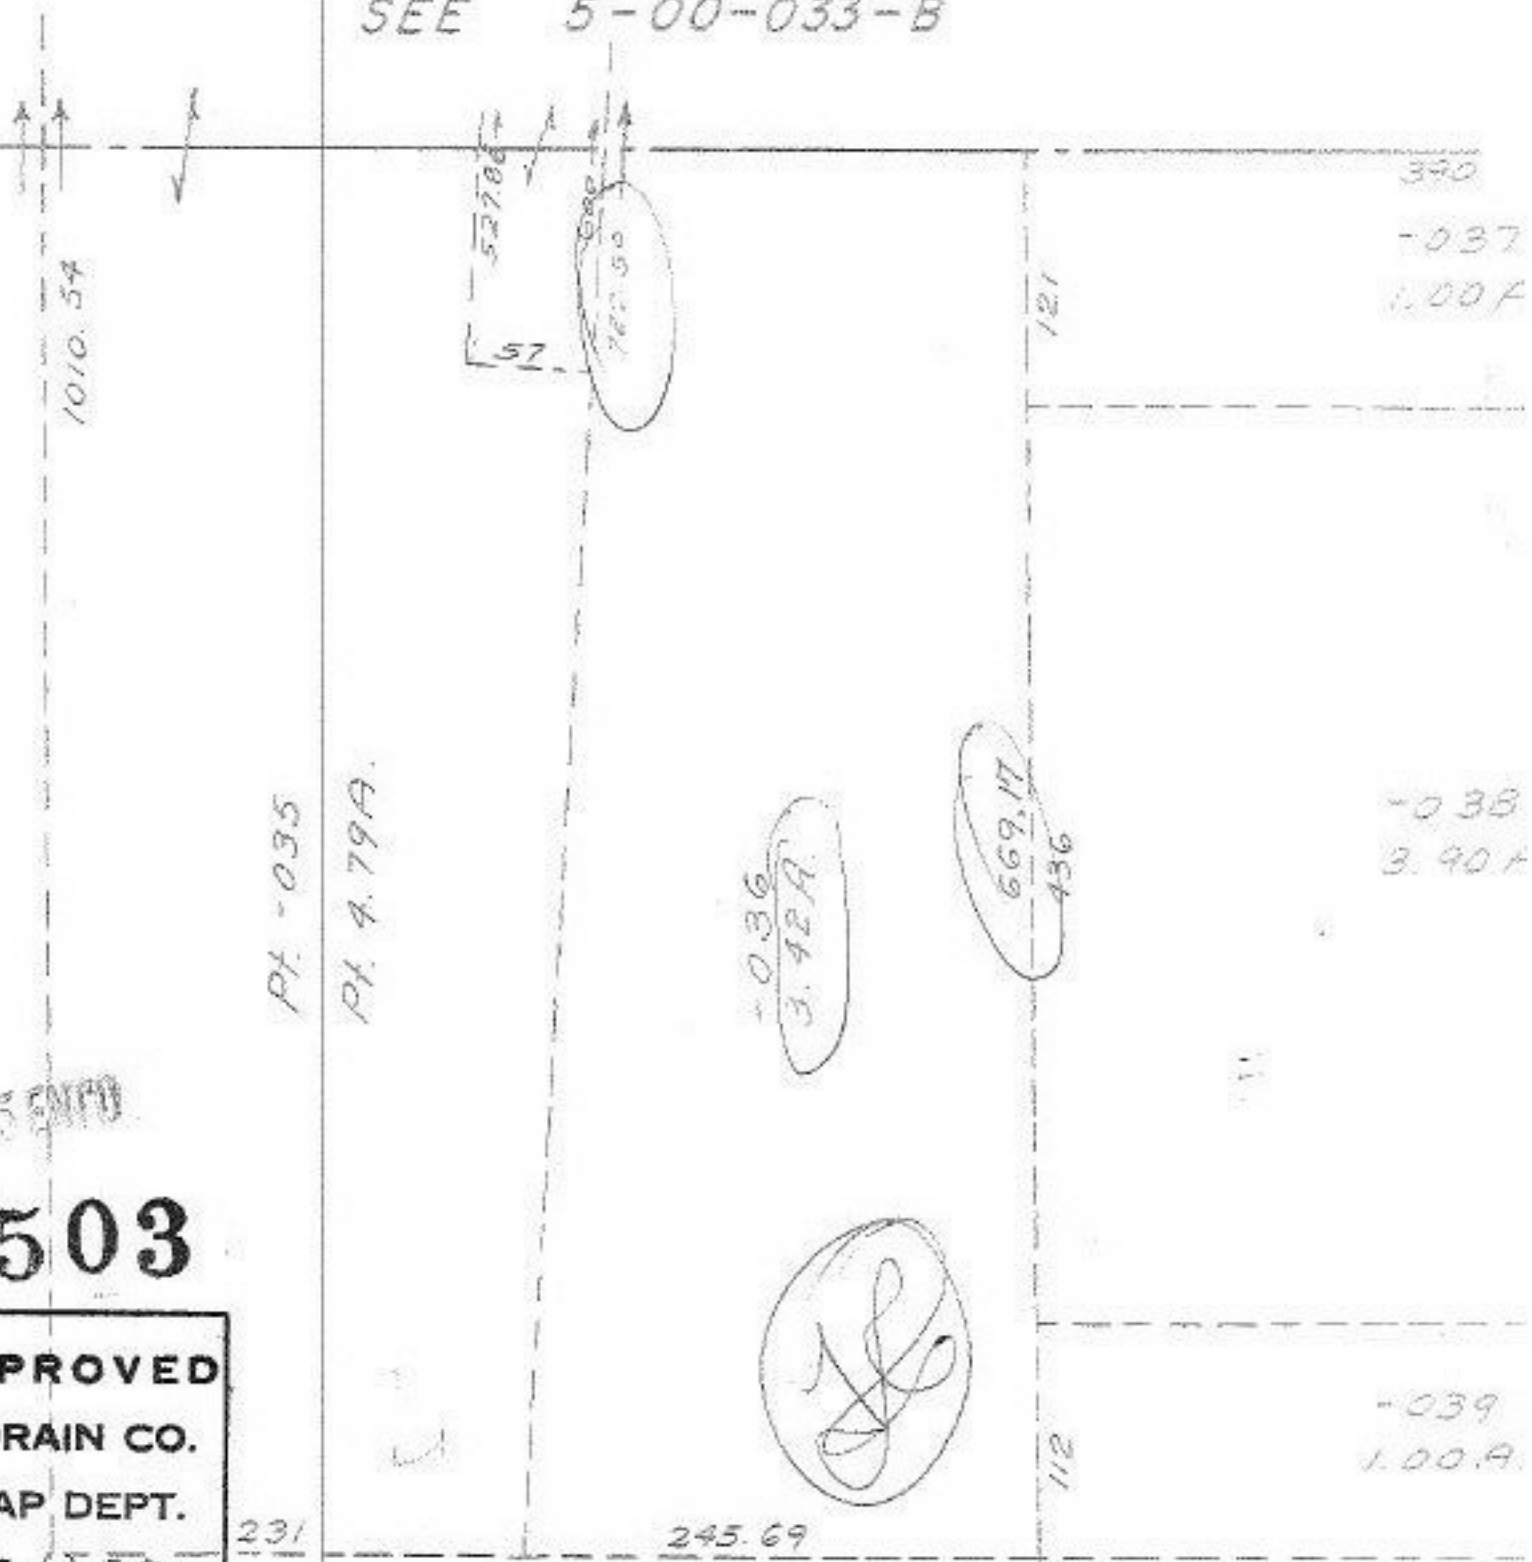

PT. -035
PT. 4.79A.

-036
3.42A

669.17
436

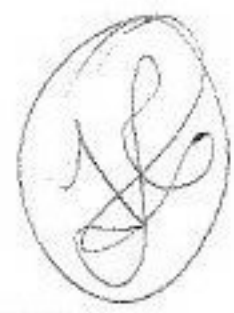

MAN SENTO

4503

APPROVED
LORAIN CO.
MAP DEPT.
DATE 12-5-76
5-00-032B
BY *[Signature]*

3-00-032-B