

4525
4525

-003
77.00A.

-004
5.00A.
577.2

377.15

-001
30.00A.


477.75

388.37
-009
1.10A
357.27

-010
-006
51.70A.
50.55

442.05

250
-005
80A
250

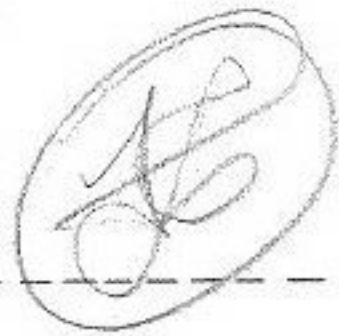

17

-008
35.00A.

230
-007
1.00A
230

4525

JAN 11 ENT'D

APPROVED
LORAIN CO.
MAP DEPT.

DATE 12/11/20

15-B

BY
R.J. Keating

-004
47.50A.



Change of Average # 4605

7-25-86 L.L.

1029
149