


4528  
~~4442~~  
4528

4528

4528  
Revised  
~~4442~~

JAN 6 1970  
7-26-86 L.L.

APPROVED  
LORAIN CO.  
MAP DEPT.  
DATE 10/27/70  
12-03-019-D  
BY  
R. L. K.

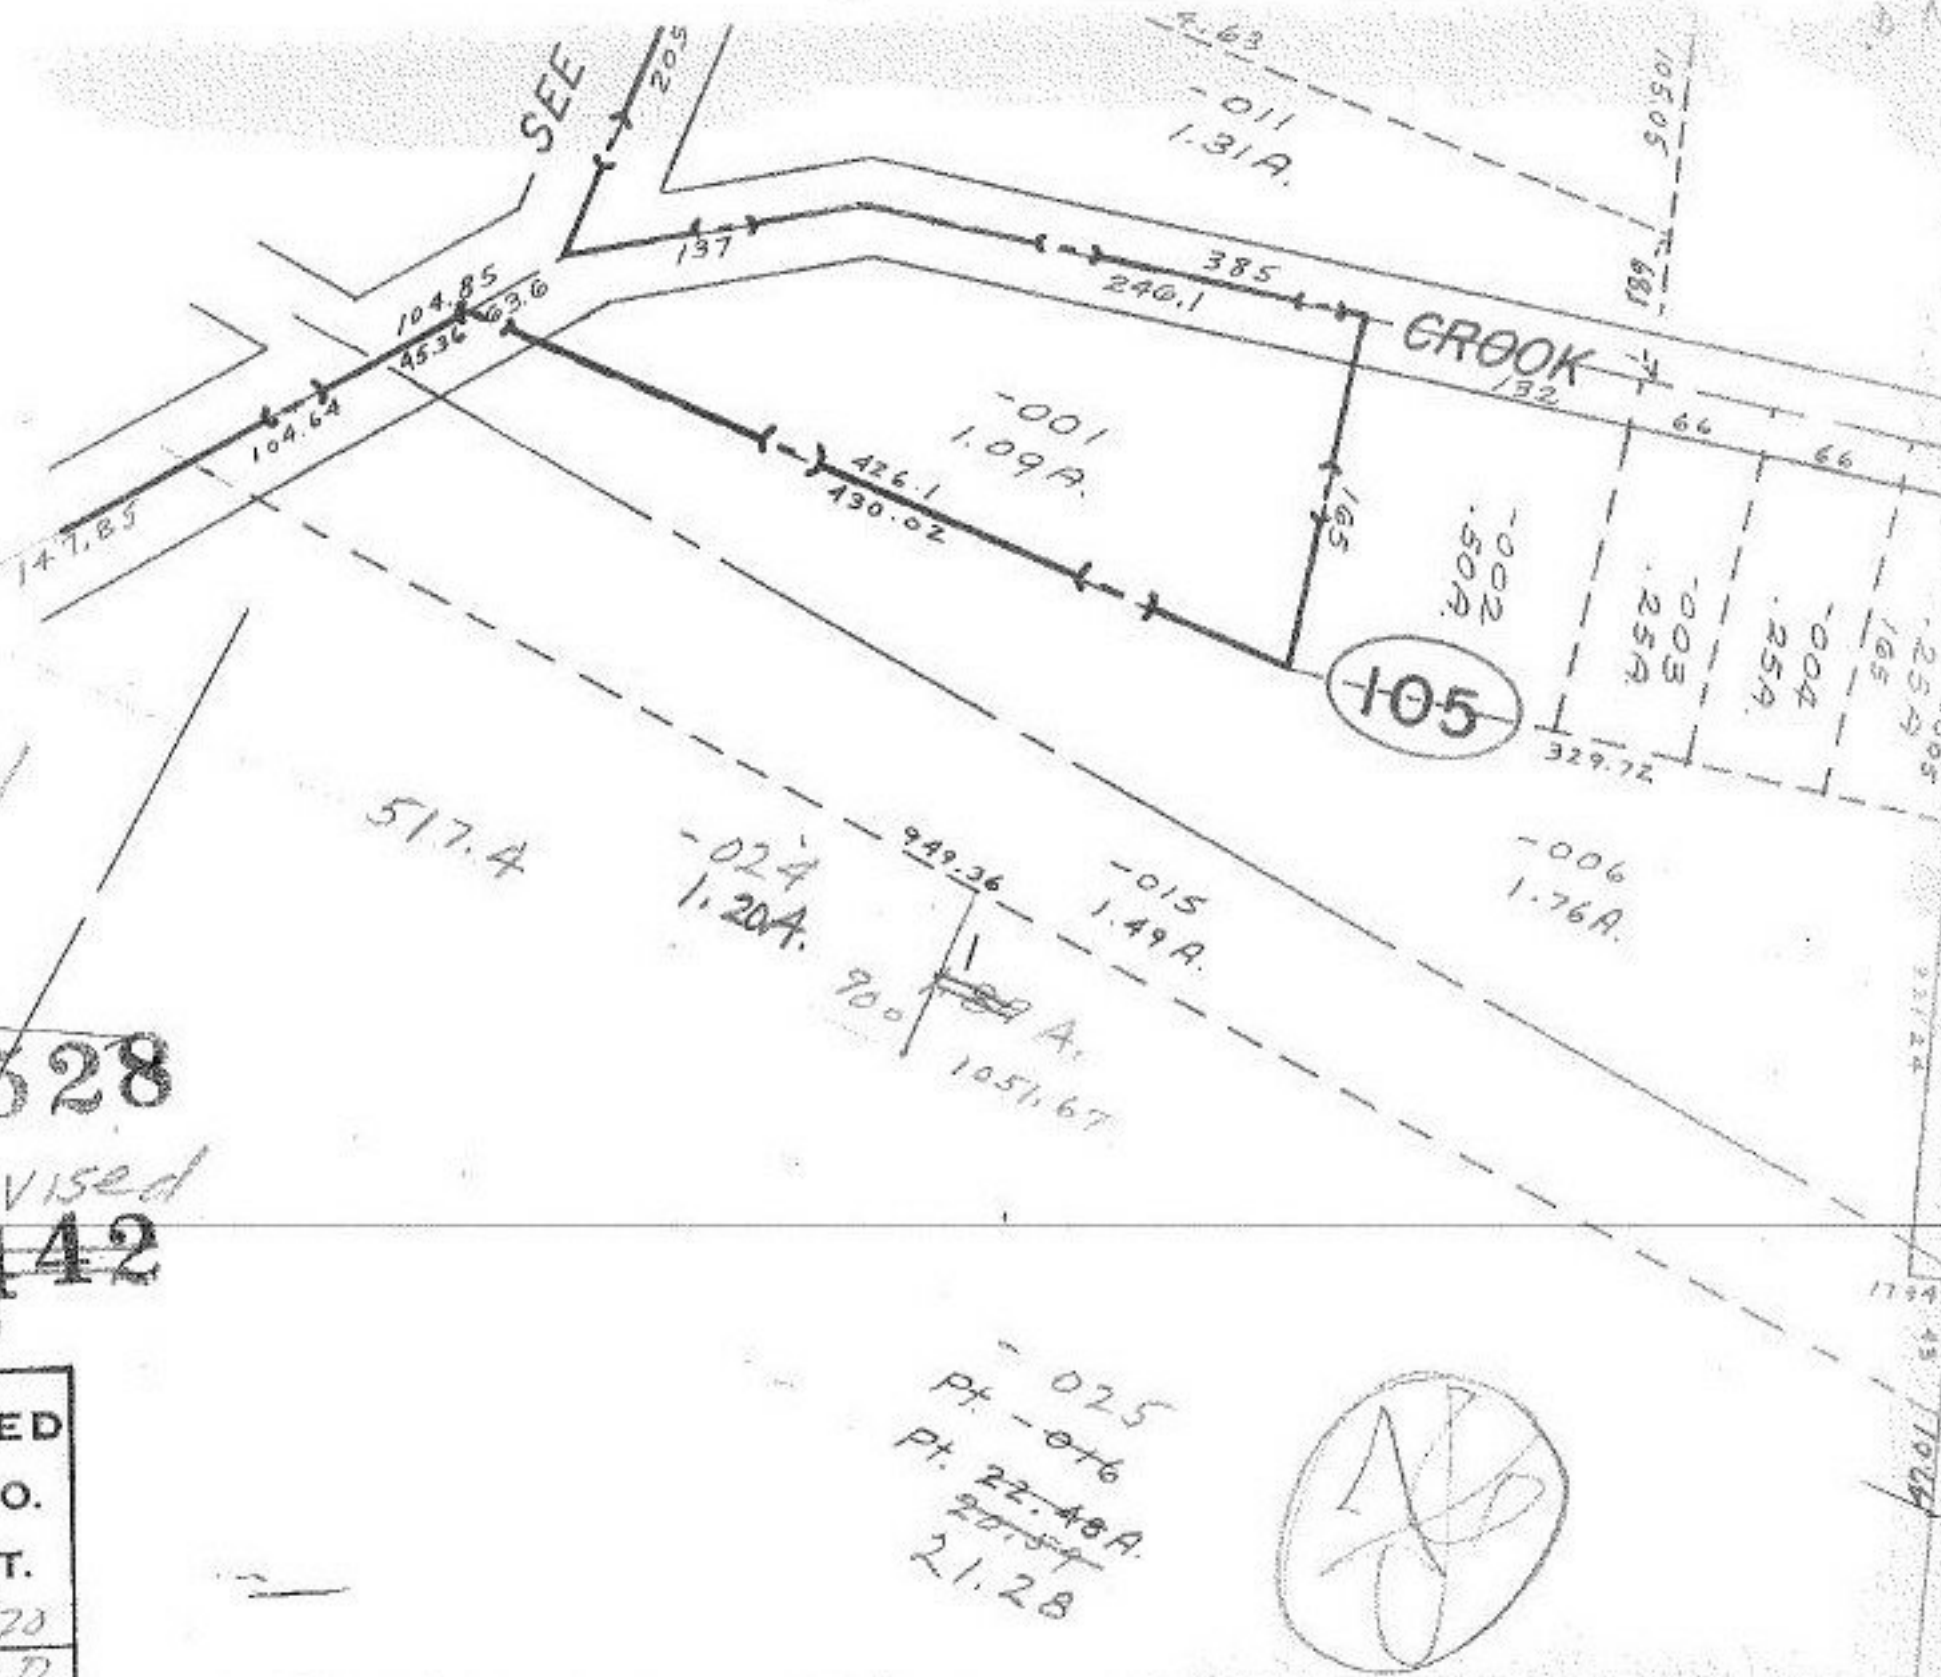

- 025  
Pt. - 0+6  
Pt. 22.48 A.  
~~20.57~~  
21.28

