


96.952
26.35
196.00
995H#

CENTER RIDGE

BARTON

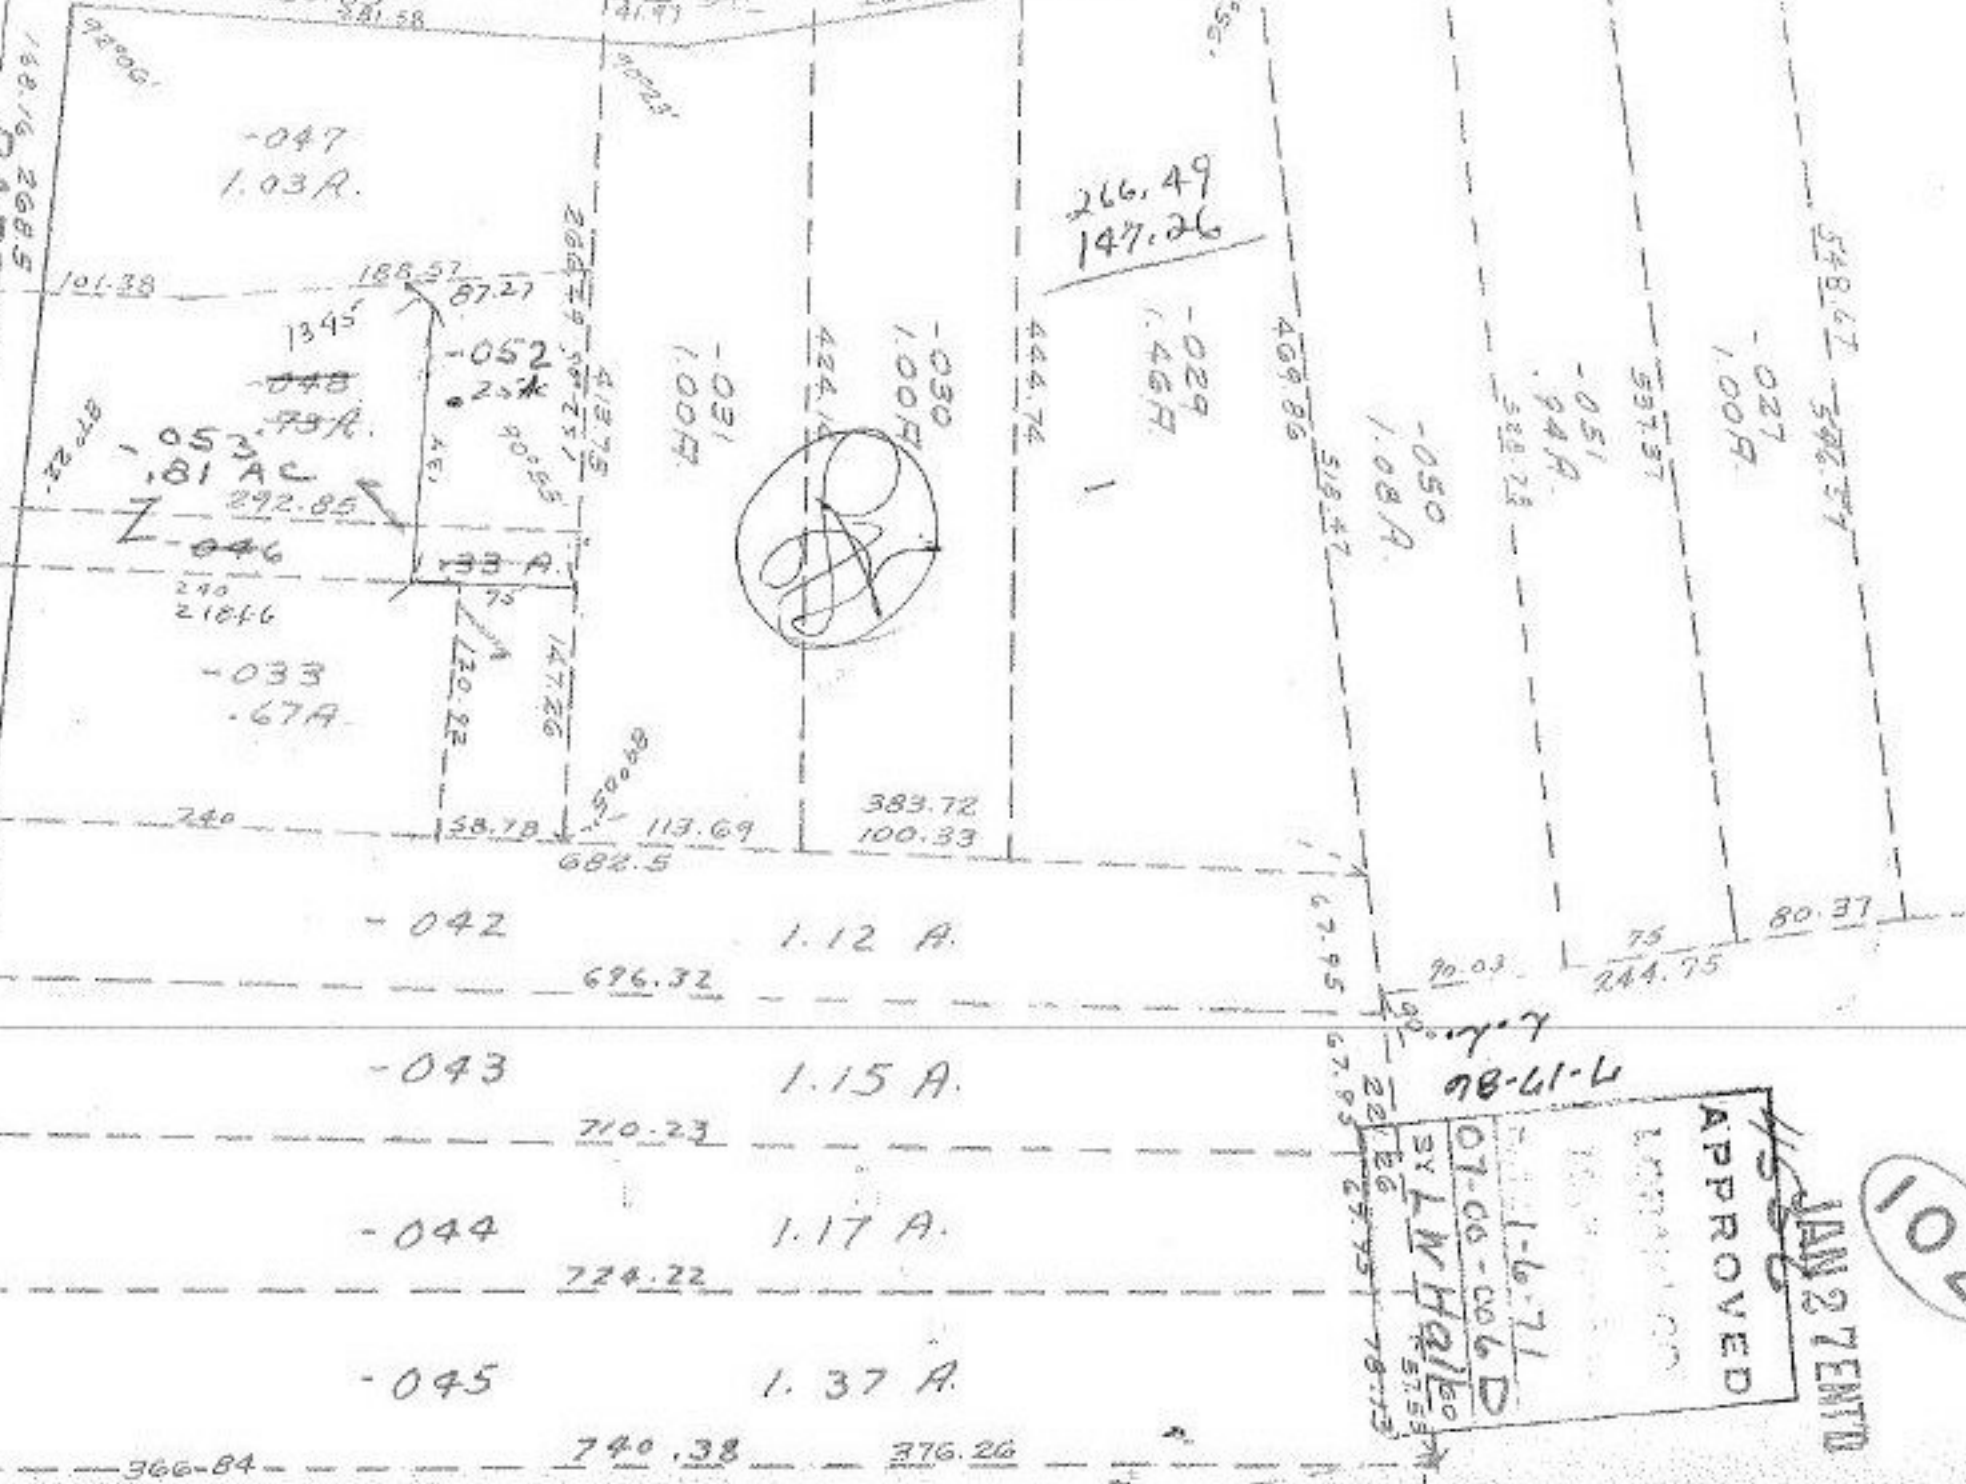

266.49
147.26

[Signature]

APPROVED
 JAN 27 ENT'D
 1-6-71
 07-06-006 D
 BY LW Hall
 5753

102

1556